


KANSAS

Ellsworth

Section 11 Township 17 Range 10W

Well No. #4 Peterman

Company Derby Oil.

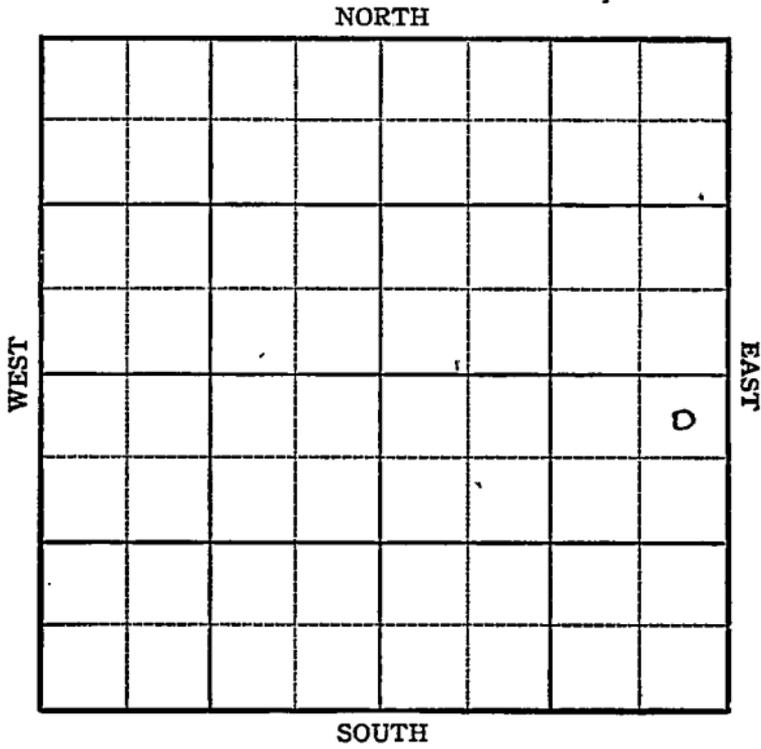

Sec. 11 Twp. 17 R. 10-W

Well No. #4 Peterman Farm

Derby Oil Company


Bloomer

330 Ft. from N. Line

_____ Ft. from S. Line

330 Ft. from E. Line

_____ Ft. from W. Line

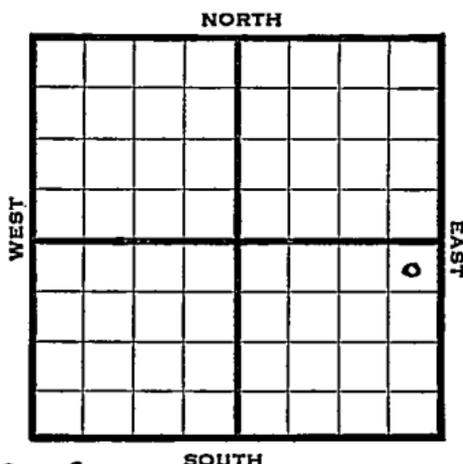

Elev. 1809

1944

REPORT

2/9

Rotary

2/15

"

2/23

8" @ 251

Drlg. 650'

3/1

Drlg. 2910'

3/8

Lans 2922 Sat 3029-46, 3114-27

Congl 3244

Arb 3261-64 TD

5" @ 3262'

Rust

3/15

TD 3283

5000 acid 10 qts 3273-83- 1300' oil.

3/22

Arb. 3261

5" @ 3262

TD 3283

10 qts. 3273-83

1800 acid

Pump 75 Pot

Gravity 42.6

COMPLETED

KANSAS

Map No. _____ Sec. 11 Twp. 17 R. 10WWell No. 4 PetermanDerby Oil Company

FIRST REPORT

Contractor _____

NE SE

SECTION PLAT

330 Ft. from N. Line

			o

_____ Ft. from S. Line

330 Ft. from E. Line

_____ Ft. from W. Line

Bloomer Pool

Location _____

Rig up _____

Drilling and Remarks:

Rotary

RECORD

Cased _____ in., _____ ft.

Sand _____

Gas _____

Oil _____

Total Depth _____

PRODUCTION

1st 24 hrs. Nat. _____

1st 24 hrs. after shot _____

Gas _____ Cu. Ft.

Dry Hole _____

Abandoned _____

Date

FEB 9 1944 19S. J. LEWIS Scout

KANSAS
 Map No. 37 Sec. 11 Twp. 17 R. 10W

Well No. 4 Peterman

Derby Oil Company

COMPLETED Contractor

NE SE

SECTION PLAT

330 Ft. from N. Line

_____ Ft. from S. Line

330 Ft. from E. Line

_____ Ft. from W. Line

			◊

Bloomer Pool

Location _____

Rig up _____

Drilling and Remarks:

Cr 3261
5" @ 3262
10 gals 3273-83
1500 acid
Pump 75 P.D.
426 gr

RECORD

Cased _____ in., _____ ft.

Sand _____

Gas _____

Oil _____

Total Depth 3283

PRODUCTION

1st 24 hrs. Nat. _____

1st 24 hrs. after shot _____

Gas _____ Cu. Ft.

Dry Hole _____

Abandoned _____

Date

MAR 22 1944 19

S. J. LEWIS Scout