

KANSAS


FORM 51 5M BR1X

Ellsworth

Section 11 Township 17 Range 10W

Well No. #2 Petermann

Company Weber Dental Mfg.

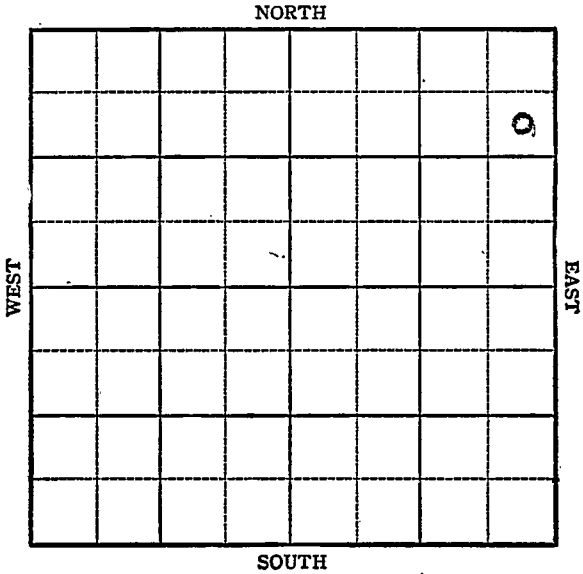

KANSAS

Ellsworth

Sec. 11 Twp. 17 R. 10W

Well No. #2 Petermann Farm

Weber Dental Mfg Company

Bloomer

NORTH

990 Ft. from N. Line


 Ft. from S. Line

330 Ft. from E. Line

 Ft. from W. Line

WEST

EAST

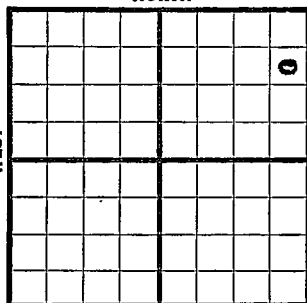

SOUTH

Elev. 1814

1944

REPORT

7/26 Spud

8/2 8" @ 238 Drlg. 2475

8/9 3190 fsg.

8/16 Drlg. 3193

8/23 Arb 3273-78 TD

5" @ 3275 RUST

8/30 TD 3297 2000 acid No Help

13 qts. 3280-96 CO

9/8 TD 3298 fsg.

9/13 " " "

9/21 " " "

9/28 TD 3306 4000 acid No Help

10/4 " " " " " "

10/11 " " " " " "

10/18 " " " " " "

10/25 " " " " " "

11/1 Arb 3273

5" @ 3275

13 qts. 3280-96

6000 acid

TD 3306

Pump 25 Pot.

Grav. 42.0

COMPLETED

Pool Name Bloomer

KANSAS

Map No. 55 Sec. 11 Twp. 17 R. 10W

Well No. 2 Petermann

Weber Dental Mfg. Company

FIRST REPORT Contractor

SE NE NE

SECTION PLAT

990 Ft. from N. Line

_____ Ft. from S. Line

330 Ft. from E. Line

_____ Ft. from W. Line

			e

Ellsworth County

RECORD

Location _____

Cased _____ in., _____ ft.

Rig up _____

Sand _____

Drilling and Remarks:

Gas _____

Spud

Oil _____

Total Depth _____

PRODUCTION

1st 24 hrs. Nat. _____

1st 24 hrs. after shot _____

Gas _____ Cu. Ft.

Dry Hole _____

Abandoned _____

Date

JUL 26 1944 19

S. J. LEWIS Scout

Pool Name Bloomer Pool

Map No. 55 Sec. 11 Twp. 17 R. 10W

Well No. 2 Pet er mann

We her Dental Mgg. Company

COMPLETED Contractor

SE NE NE

SECTION PLAT

990 Ft. from N. Line

 Ft. from S. Line

330 Ft. from E. Line

 Ft. from W. Line

Ellsworth

Location

Rig up

Drilling and Remarks:

As 8273
51028275
18928270-96
6000 acid
Pump 250 P
42 1/2 Gr

RECORD

Cased in., ft.

Sand

Gas

Oil

Total Depth 2316

PRODUCTION

1st 24 hrs. Nat.

1st 24 hrs. after shot

Gas Cu. Ft.

Dry Hole

Abandoned

Date