

KANSAS

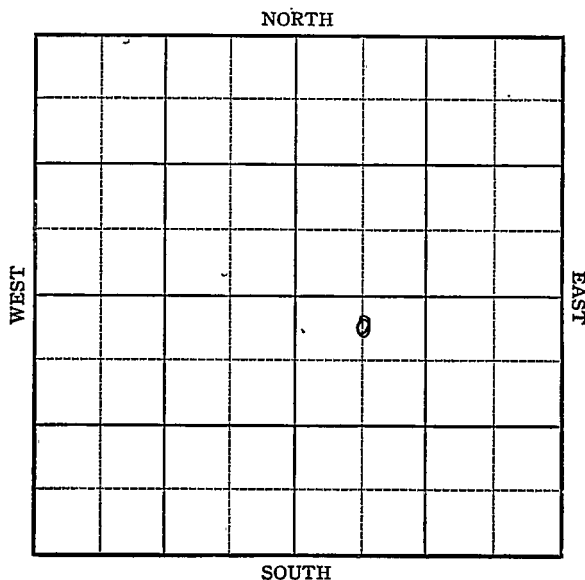
FORM 51 5M PETROL

Ellsworth

Section 11 Township 17 Range 10-W

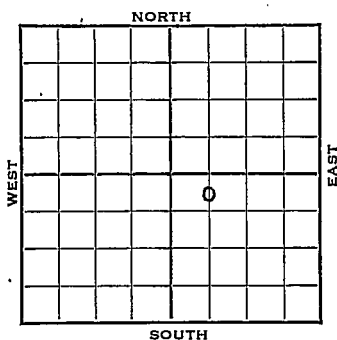
Well No. #3 Petermann

Company Derby



KANSAS

Ellsworth

Sec. 11 Twp. 17 R. 10-WWell No. #3 Petermann FarmDerby Company330 Ft. from N. Line Ft. from S. Line Ft. from E. Line660 Ft. from W. LineELEV. 1816

1943

REPORT

8/25 Location

9/1 "

9/8 Notary

9/15 8" @ 235'
Drlg. 888

9/22 Drlg. 2805'

9/29 Cong 3258
T.D. 3307 in Cong
T.D. 3307'

ABANDONED

KANSAS

Map No. 55 Sec. 11 Twp. 17 R. 10WWell No. 3 PetermannDerby

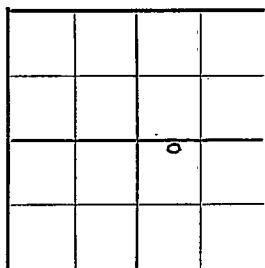
Company

FIRST REPORT

Contractor

C N L NW SE

SECTION PLAT

330 Ft. from N. Line

Ft. from S. Line

Ft. from E. Line

660 Ft. from W. Line

Bloomer Pool

Location X

Rig up

Drilling and Remarks:

RECORD

Cased _____ in., _____ ft.

Sand _____

Gas _____

Oil _____

Total Depth _____

PRODUCTION

1st 24 hrs. Nat. _____

1st 24 hrs. after shot _____

Gas _____ Cu. Ft.

Dry Hole _____

Abandoned _____

Date

AUG 25 1942

19

S. J. LEWIS

Scout

KANSASMap No. 52 Sec. 11 Twp. 17 R. 10WWell No. 3 PetermannDerby CompanyABANDONED Contractor

C N L NW SE

SECTION PLAT

330 Ft. from N. Line Ft. from S. Line Ft. from E. Line660 Ft. from W. LineBloomer PoolLocation ~~X~~Rig up

Drilling and Remarks:

Coing 8258YD 3307 in Coing

RECORD

Cased in., ft.Sand Gas Oil Total Depth 3307

PRODUCTION

1st 24 hrs. Nat. 1st 24 hrs. after shot Gas Cu. Ft.Dry Hole Abandoned

Date

SEP 29 1943 19S. J. LEWIS Scout