

LAUGHLIN-SIMMONS & CO. OF KANSAS INC.

Oil Well Elevations and Locations
2121 W. 18th 316-WH3-5351
Wichita, Kansas 67203

July 15, 1969
DATE

Barton 22 17s 12w SE NE SW
COUNTY S T R LOCATION

Glen Rupe 1 Birzer
OPERATOR NO. FARM


Mr. Glen N. Rupe
222 Brown Building
Wichita, Kansas 67202

JUL 16 1969

Authorized by Mr. Rupe 1856 DF
Scale Tel. No. Elevation

Remarks:

Left at rig, 9:15 AM

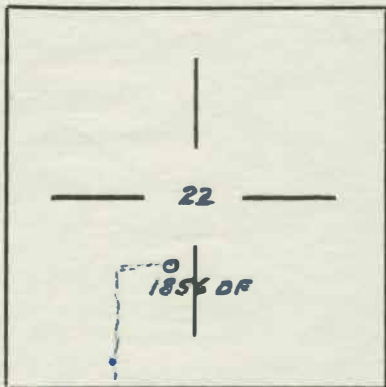

Thanks

R. E. Moser
LS Engineer

Minimum Staking Charge: _____

Elevation Charge: \$20.00

Extra Time and Mileage: _____

TOTAL \$20.00