


STATE OF KANSAS  
STATE CORPORATION COMMISSION

Give All Information Completely  
Make Required Affidavit  
Mail or Deliver Report to:  
Conservation Division  
State Corporation Commission  
P. O. Box 17027  
Wichita, Kansas 67217  
NORTH

WELL PLUGGING RECORD

REC'D AUG 2 1973  
Form CP-4

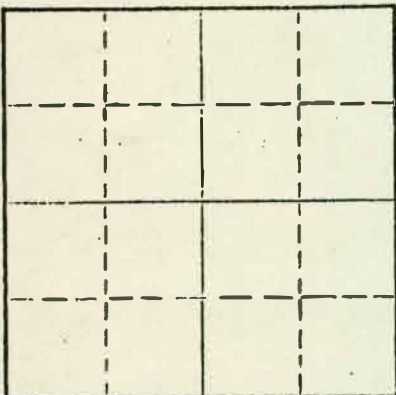

Locate well correctly on above Section Plot

Barton County, Sec 5 Twp 17 Rge 12 (E) (W) X  
Location as "NE/CNW/SW" or footage from lines NE/NE/NE  
Lease Owner Glen Rupe  
Lease Name Schiller Well No. 1  
Office Address 200 W. Douglas, Suite 925 Wichita, Kansas 67202  
Character of Well (completed as Oil, Gas or Dry Hole) \_\_\_\_\_  
Date well completed \_\_\_\_\_ 19\_\_\_\_  
Application for plugging filed \_\_\_\_\_ 19\_\_\_\_  
Application for plugging approved \_\_\_\_\_ 19\_\_\_\_  
Plugging commenced July 24, 1973  
Plugging completed July 30, 1973  
Reason for abandonment of well or producing formation Depleted

If a producing well is abandoned, date of last production \_\_\_\_\_ 19\_\_\_\_  
Was permission obtained from the Conservation Division or its agents before plugging was commenced? Yes

Name of Conservation Agent who supervised plugging of this well Don Truan  
Producing formation \_\_\_\_\_ Depth to top \_\_\_\_\_ Bottom \_\_\_\_\_ Total Depth of Well 3456 Feet  
Show depth and thickness of all water, oil and gas formations.

OIL, GAS OR WATER RECORDS

CASING RECORD

FORMATION	CONTENT	FROM	TO	SIZE	PUT IN	PULLED OUT
				8 5/8	332	-0-
				4 1/2	3445	2615.00'

Describe in detail the manner in which the well was plugged, indicating where the mud fluid was placed and the method or methods used in introducing it into the hole. If cement or other plugs were used, state the character of same and depth placed, from \_\_\_\_\_ feet to \_\_\_\_\_ feet for each plug set.

Pushed a plug to 3000 ft., dumped 20 ft. sand and 5 sacks cement. Shot casing at 2900, 2815 and 2615 ft. Pulled 77 joints of 4 1/2" casing. Allied squeezed with 3 sacks hulls, 15 sacks gel and 100 sacks cement.

(If additional description is necessary, use BACK of this sheet)  
Name of Plugging Contractor Rockhold Eng., Inc.  
Address P. O. Box 698 Great Bend, Kansas 67530

STATE OF KANSAS COUNTY OF BARTON, ss.  
James W. Rockhold (employee of owner) or (owner or operator) of the above-described well, being first duly sworn on oath, says: That I have knowledge of the facts, statements, and matters hereto contained and the log of the above-described well as filed and that the same are true and correct. So help me God.



(Signature) James W. Rockhold  
Box 698 Great Bend, Ks. 67530 James W. Rockhold  
(Address)  
30th day of July, 1973  
Cathy Miller  
Cathy Miller Notary Public.

My commission expires Sept. 30, 1975

State of Kansas



# State Corporation Commission

## CONSERVATION DIVISION

(Oil, Gas and Water)

P. O. Box 17027      3830 S. Meridian  
WICHITA, KANSAS 67217

July 25, 1973

### WELL PLUGGING AUTHORITY

Well No.	1
Lease	<del>Schiller</del>
Description	NE NE NE 5-17-12W
County	Barton
Total Depth	3456
Plugging Contractor	Rockhold Engineering, Inc.

Glen Rupe  
925 O. W. Garvey Bldg.,  
Wichita, Kansas 67202

Gentlemen:

This is your authority to plug the above subject well in accordance with the Rules and Regulations of the State Corporation Commission.

This authority is void after 90 days from the above date.

Yours very truly,

*J. Lewis Brock*  
J. Lewis Brock, Administrator

Mr. Donald Truan Box 148 Russell, Kansas  
is hereby assigned to supervise the plugging of the above named well.

REC'D JUL 27 1973

# RAPID WELL SERVICE, INC.

PHONE 483-3362 — RUSSELL, KANSAS — P. O. BOX 208

No 2011

APR. 25 1972

COMPANY Glen Ruge

ORDERED BY \_\_\_\_\_

ADDRESS \_\_\_\_\_

ORDER NO. \_\_\_\_\_

LEASE Schiller WELL NO. 1

WORK STARTED \_\_\_\_\_ COMPLETED

## WELL PULLING REPORT

PULLED			EQUIPMENT	RUN		
JTS.	FT.	DESCRIPTION		JTS.	FT.	DESCRIPTION
			Anchor			
			Perf.			
			Working Barrel			
			Hold Down			
			Tubing			
			Tubing Subs			
			Standing Valve			
			Traveling Valve			
		<u>2" x 1 1/2" x 10' RWT</u>	Pumps		<u>2" x 1 1/2" x 12' R.W.T.</u>	
		<u>133 3/4</u>	Rods		<u>133 3/4</u>	
			Rods			
		<u>1-4' 3/4 on Pump 1-6' 3/4</u>	Rod Subs		<u>1-2' 3/4 on Pump 1-6' 3/4</u>	
		<u>Below Polish Rod</u>	Polish Rod		<u>Below Polish Rod</u>	
No.		Kind	Balls and Seats			
No.		Kind	Cups			

SERVICES		Hours	Per Hour	Amount
UNIT AND POWER TOOLS		6	\$ 9.75	\$
OPERATOR	<u>E. Karat</u>	6	\$ 3.85	\$
LABOR	<u>August Berhardt</u>	6	\$ 3.45	\$
	<u>Jim Burns</u>	6	\$ 3.45	\$
OTHER CHARGES			\$	\$
			<b>TOTAL:</b>	\$

REMARKS: moved to Loc, Rigged up, Pulled rods + Pump, Plunger was stuck in B.C. Tube on Pump, changed Pump, Run Record Pump + rods, hung well on, string down.

RAPID WELL SERVICE, INC. BY Elmer L. Karat

U. S. INDUSTRIES, INC.

PETROLEUM EQUIPMENT DIVISION

161 CLAFLIN, KS BRANCH

PROPERTY OF GLENN W. RUPE

Field \_\_\_\_\_ Lease & Well No. HITCHMAN Pump No. #1

Type Pump RWT Size 2" Bore 1 1/2" Length 12'

Type Liners NONE Type Plunger H.C.F. Length 51" Fit .004

Type Tube PREP. HONED STEEL Maximum Stroke 78"

Remarks: 2" x 1 1/2" x 12' RWT w/ 51" H.C.F. PLGR. DOUBLE

VALUED BY AERITE OHS ALL STEEL CAGES REG. STEEL PULL

TWR  
Date Repaired or Assembled 3-1-72 Sale No. \_\_\_\_\_ Date 3-1-72

FORM NO. 8