

Section 12 Township 17 Range 9 WWell No. # 1 JanzenCompany Petroleum Inc.

0							

NORTH

WEST

EAST

SOUTH

5

12

17

9W

Sec. _____ Twp. _____ R. _____

#1 Janzen

Well No. _____ Farm _____

Petroleum, Inc.

Company _____

Garvey

Contractor _____

Lorraine Pool

Ft. from N. Line _____

330


Ft. from S. Line _____

Ft. from E. Line _____

330

Ft. from W. Line _____

SW SW NW

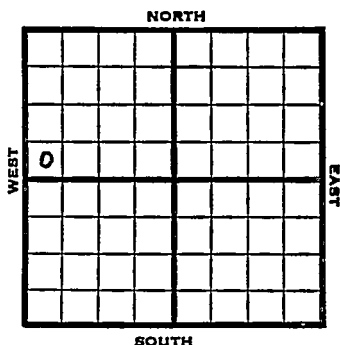

1953

Elev. 1816' REPORT

7/22

Spud 7-15-53

8" @ 200

Drlg. 1676'

7/29

Drlg. 2800'

8/5

Heeb 2728' Br li 2850' Lans 2875

DST 3010-45, 35 mins, 12' M

DST 3050-80, 1 hr, 150' SOCM 450#

Cong 3190'

DST 3174-3216, 35 mins, 22' M 400#

Arb. 3237'

DST 3236-40, 35 min, 25' SOCM, 775#

DST 3240-46, 1 hr, 500' SW 900#

#TD 3246' 4" @ 3175

8/12

20/3066-71, S/M CO

8/19

2500A

S/2 boph + trace, POP

OVER

1953

9/16

Spud 7-15-53

Oil Well

TD 3246

8" @ 200'

Heeb 2728, Br lime 2850, Lans 2865
DST 3010-45, opn 35 mins., rec. 12'
mud

DST 3050-80, opn 1 hr., rec. 150'
socm, 450#

Cong 3190

DST 3174-3216, opn 35 mins., rec.
22' mud, 400#

Arb. 3237

DST 3236-40, opn 35 mins., rec. 25'
socm, 775#

DST 3240-46, opn 1 hr., rec. 500' sw,
900#

TD 3246

4" @ 3175, 20/3066-71, S/mud, 2500A
S/2 boph

Comp. 50 bopd

COMPLETED

County Ellsworth State Kansas
 Sec. 12 (Blk.) 17 (Sur.) 9W Map No.
 Operator Petroleum Inc.
 Well No. 1 Farm Janzen

Elev. _____ Location SW SW NW

330 Ft. From S Line NW

330 Ft. From W Line Quarter

1st. Report JUL 2 1953

Completion _____

Remarks _____

Garvey - Contr.

Spudding Date 7-15-53

Drlg. Data Lorraine Pool


8" @ 200 drlg. 1676

JUL 24 1953

Scout Cards	_____
Land Small Map	_____
Land Wall Map	_____
Tracings	_____
France Map	_____
Pierce Map	_____
Misc.	_____

Orig. Data

County Ellsworth State Kansas
 Sec. 12 (Blk.) 17 (Sur.) 9W Map No. _____
 Operator Petroleum Inc.
 Well No. 1 Farm Janzen
 Elev. 1816 Location SW SW NW

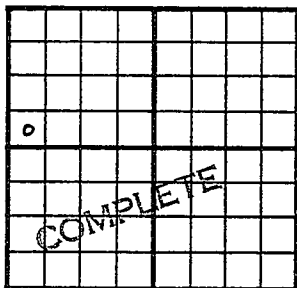

330 Ft. From S Line NW

330 Ft. From W Line Quarter

1st. Report

Completion SEP 16 1953

Remarks Lorraine Pool

Garvey - Contr.

Spudding Date 7-15-53

Drilg. Data Oil well TD 3246

8" @ 200 Heeb. 2728 Br. lime 2850

Lans. 2865 DST 3010-45 open 35 min.

Rec. 12' mud DST 3050-80 open 1 hr.

Rec. 150' socm 450# Cong. 3190

DST 3174-3216 open 35 min. Rec. 22' mud

400# Arb. 3237 DST 3236-40 open 35 min.

Rec. 25' socm 775# DST 3240-46 open 1 hr.

Rec. 500' sw 900# TD 3246 4" @ 3175

20/ 3066-71 S/ mud 2500 A S/ 2 boph

Comp. 50 bopd

J. G. MCGEEHEE

SEP 23 1953

Scout Cards	48
Land Small Map	
Land Wall Map	53
Tracings	
France Map	
Pierce Map	
Misc	

Drig. Data