

Section 12 Township 17 Range 9 W

Well No. # 1 Janzen

Company Elreco Ref.

NORTH

4

	0	-					

WEST

EAST

SOUTH

Sec. 12 Twp. 17 R. 9W

Well No. #1 Janzen Farm

Elreco Ref. Company

Pickrell Drlg. Contractor
Wildcat.


330 Ft. from N. Line

_____ Ft. from S. Line

_____ Ft. from E. Line

990 Ft. from W. Line

NE NW NW

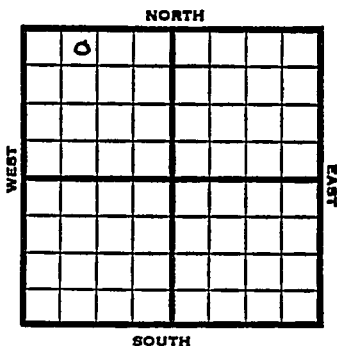

1953 Elev. 1814' REPORT

6/24 Spud 6-15-53
8" @ 251'
Heeb 2746, Dodge 2767, Doug. 2778,
Br. Lime 2868, KC 2886
Drlg 3163'

7/1 Spud 6-15-53 D & A TD 3314
8" @ 251 Heeb 2746 Dodge 2767
Doug. 2778 Br line 2868 KC 2886
Simp 3246 Arb. 3299 TD 3314
D & A

ABANDONED

County Ellsworth State Kansas

Sec. 12 (Blk. Twp.) 17 (Sur. Rge.) 9W Map No.

Operator Elreco Ref.

Well No. 1 Farm Janzen

Elev. 1814 Location NE NW NW

0					

330 Ft. From N Line NW

990 Ft. From W Line Quarter

1st. Report JUN 24 1953

Completion

Remarks

Pickrell Drlg. - Contr.

Spudding Date 6-15-53

Drlg. Data Wildcat

8" @ 251 Heeb. 2746 Dodge 2767

Doug. 2778 Br. lime 2868 RC 2886

drlg. 3163

County Ellsworth State Kansas

Sec. 12 (Blk. 17 (Sur. 9W (Twp.) Rge.) Map No.

Operator ElReco Ref.

Well No. 1 Farm Jansen

Elev. 1814 Location NE NW NW

0					

330 Ft. From N Line NW

990 Ft. From W Line Quarter

Ist. Report

Completion JUL 1 1953

Remarks Wildcat

Pickrell Drlg. - Contr.

Spudding Date 6-15-53

Drlg. Data D & A TD 3314

8" @ 251 Heeb. 2746 Dodge 2767

Doug. 2778 Br. lime 2868 KC 2886

Simp. 3246 Arb. 3299 TD 3314

D & A