FORM 51 5M BRIX


KANSAS

Ellsworth

Section 12 Township 17 Range 10W

Well No. #3 Ploog

Company Bay Pet

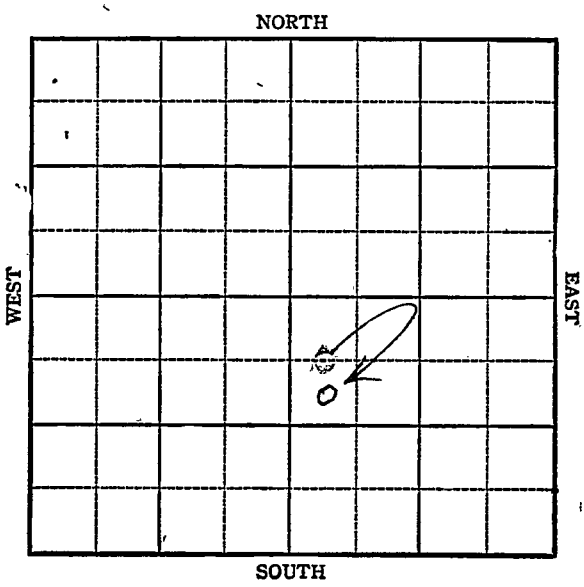

FORM 252-A
5M 9-44 PETROL

KANSAS Ellsworth County

Sec. 12 Twp. 17S R. 10W

Well No. #3, Ploog Farm

Bay Petroleum Company

Stoltenberg


990 Ft. from N. Line

Ft. from S. Line

Ft. from E. Line

330 Ft. from W. Line

C ~~SW~~ NW SE

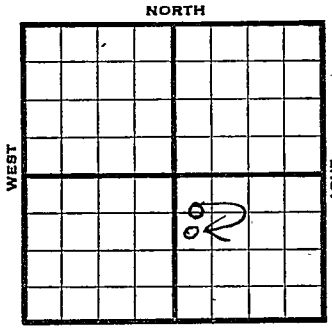

1944	REPORT
11-15	Location
11/24	8" @ 400 Anhy 526 Drlg. 1480
11/29	Drlg. 3100
12/6	Arb. 3271 TD 3296'

ABANDONED

FORM 56 200 BKS, 1-44 PETROL

Pool Name Stoltenberg

Map No. 51 Sec. 12 Twp. 17 R. 10W


Well No. 3 Ploog

Bay Pet Company

FIRST REPORT Contractor

C W L NW SE

SECTION PLAT

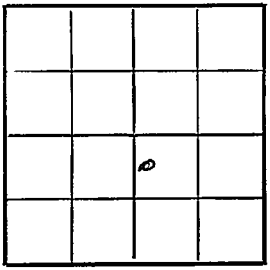

660 Ft. from N. Line

Ft. from S. Line

Ft. from E. Line

330 Ft. from W. Line

Ellsworth

Location X

Rig up

Drilling and Remarks:

RECORD

Cased in., ft.

Sand

Gas

Oil

Total Depth

PRODUCTION

1st 24 hrs. Nat.

1st 24 hrs. after shot

Gas Cu. Ft.

Dry Hole

Abandoned

Date

NOV 15 1944 19 S. J. LEWIS Scout

FORM 26 200 BKS 1-44 PETROL

Pool Name Stoltenberg

Map No. 55 Sec. 12 Twp. 17 R. 10W

Well No. 3 Ploog

Bay Pet Company

CORRECTION Contractor

SW NW SE


990 Ft. from N. Line

_____ Ft. from S. Line

_____ Ft. from E. Line

330 Ft. from W. Line

SECTION PLAT

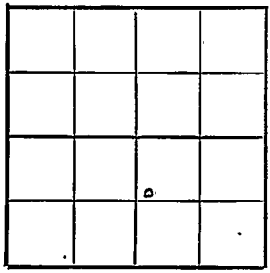

Ellsworth

Location

Rig up

Drilling and Remarks:

Reported

C W L NW SE

RECORD

Cased ____ in., ____ ft.

Sand

Gas

Oil

Total Depth

PRODUCTION

1st 24 hrs. Nat.

1st 24 hrs. after shot

Gas ____ Cu. Ft.

Dry Hole

Abandoned

Date

NOV 29 1944 19

S. J. LEWIS Scout

FORM 26 200 BKS 1-44 PETROL

Pool Name Stoltenberg

Map No.)) Sec. 12 Twp. 17 R. 10W

Well No. 3 Ploog

Bay Pet. Company

ABANDONED Contractor

SW NW SE


990 Ft. from N. Line

____ Ft. from S. Line

____ Ft. from E. Line

330 Ft. from W. Line

SECTION PLAT

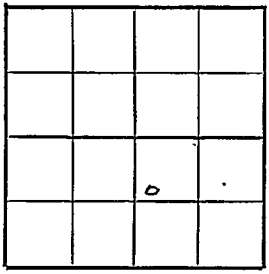

Ellsworth

Location

Rig up

Drilling and Remarks:

Cer #3271

RECORD

Cased ____ in., ____ ft.

Sand

Gas

Oil

Total Depth 2256

PRODUCTION

1st 24 hrs. Nat.

1st 24 hrs. after shot

Gas ____ Cu. Ft.

Dry Hole

Abandoned

Date

DEC 6 1944 19 S. J. LEWIS Scout