
FORM 51 25M 8-50 WESTERN Ellsworth KANSAS

Section 12 Township 17 Range 10 W

Well No. # 3 Ploog

Company Mallard Drlg.

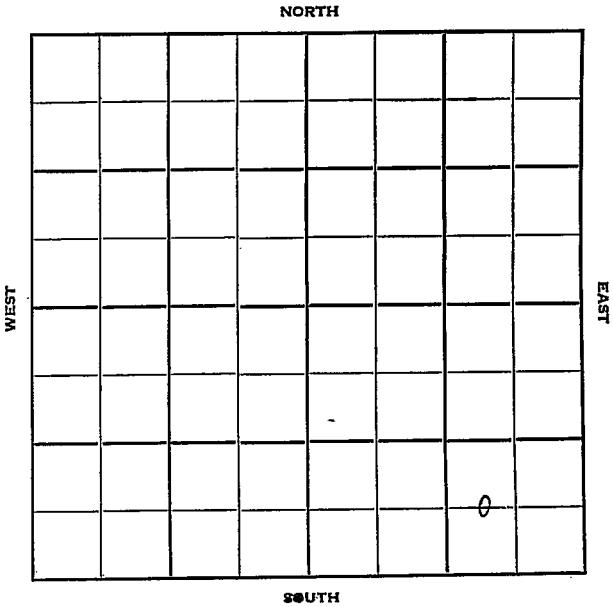

FORM 252-B
10M 11-50 PETROL

Ellsworth KANSAS

Sec. 12 Twp. 17 R. 10 W

Well No. # 3 Ploog Farm

Mallard Drlg. Company

Contractor


_____ Ft. from N. Line

660 Ft. from S. Line

990 Ft. from E. Line

_____ Ft. from W. Line

C W/2 SE SE

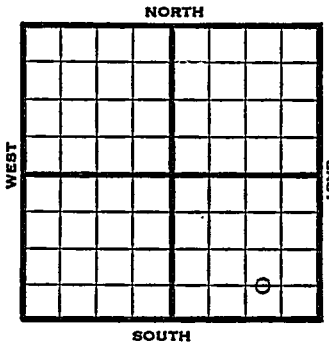

1951	Elev. 1790' REPORT
6/20	Spud 6-15-51 8" @ 195' Drlg. 1775'
7/11	Spud 6-15-51 D&A TD 3269 8" @ 195 Heeb. 2783 Br Lime 2902 Lans. 2911 Arb. 3243 TD 3249 5" @ 3244 1000 A DD 3269 D&A ABANDONED

FORM 275 FOR SALE BY KANSAS BLUE PRINT CO.


County Ellsworth State Kansas

Sec. 12 (Blk. Twp.) 17 (Sur. Rge.) 10W Map No.

Operator Mallard Drlg.

Well No. 3 Farm Ploog

Elev. Location CW/2 SE SE

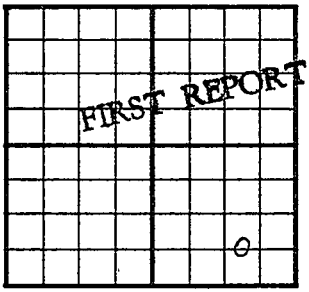

660 Ft. From S Line SE

990 Ft. From E Line Quarter

1st. Report JUN 20 1951

Completion

Remarks

Spudding Date 6-15-51

Drlg. Data

8" @ 195' Drlg. 1775

J. E. TYRA

FORM 275 FOR SALE BY KANSAS BLUE PRINT CO.


County Ellsworth State Kansas

Sec. 12 (Blk. Twp.) 17 (Sur. Rge.) 10W Map No.

Operator Mallard Drlg.

Well No. 3 Farm Ploog

Elev. 1790 Location C W L SE SE

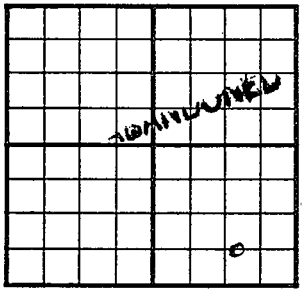

660 Ft. From S Line SE

990 Ft. From E Line Quarter

1st. Report

Completion JUL 11 1951

Remarks

Spudding Date 6-15-51

Drlg. Data D & A TD 3269

8" @ 195 Heeb. 2783 Br. lime 2902

Lans. 2911 Arb. 3243 TD 3249

5" @ 3244 1000 A DD 3269

D & A

J. E. TYRA