

Ellsworth

Form 51-5M-11-31-Palace

Map No. **KANSAS** Sec. *12* Twp. *17* R. *10^w*

Well No. *1-Stratman* Farm

Smith-Ash & Texas Company

NORTH

						0	

WEST

EAST

SOUTH

Location _____

Drilling Remarks _____

Rig Up _____

Drilling Remarks _____

RECORD

Cased _____ in. _____ ft.

Sand _____

Gas _____

Oil _____

Total Depth _____

PRODUCTION

1st 24 hrs. Nat. _____

1st 24 hrs. after shot _____

Gas _____ cu. ft. _____

Dry Hole _____

Abandoned _____

Map No. **KANSAS** Sec. 12 Twp. 17 R. 10^w
Well No. 1 - Strateman Farm
Smith-Ash & Texas Co. Company


330 Ft. from N. Line

_____ Ft. from S. Line

990 Ft. from E. Line

_____ Ft. from W. Line

1932

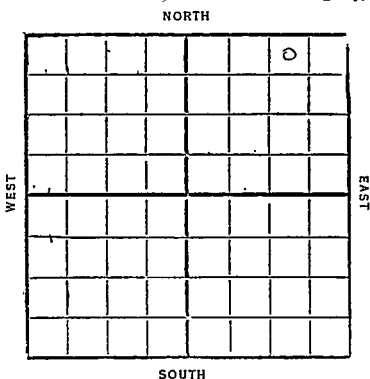

Date	REPORT
3/9	Loc
3/16	ROS.
3/22	
3/30	Run up
4/6	Spdg
4/13	15 1/2" - 335
	12 1/2" - 531
	Drlg 1087
4/20	" 1880
4/27	" 2580
5/4	1/2 pt gas at 2864
	show oil & water 3040-45
	drlg 3045
5/11	Top Conglomerate 3235
	5" liner 3261
	Silic lime 3263-66
	TD 3266
	2200' oil in 4 1/2 hrs
	swab 33 bbl per hr
	swbg 300' off bottom
	Well deepen
	(over)

5/18- Deepened to
TD 3281
swab 75 bbl 1 hour

5/25- TD 3281 No test

6/1- TD 3281
swab 45 bbl per hour

6/8- TD 3281
swab 72 bbl 1st hr
" 44 " per hr
for next 3 hr
Deepened to
TD 3285
Hole full oil

6/16- Silic 3263-85
TD 3285
Potential prod
1734 bbl 24 hr
on pump
Comp.

Ellsworth

55

KANSAS

Map No. _____ Sec. 12 Twp. 17 R. 10 ^WWell No. 1 StratmanSmith - Ash & Texas Co Company

Contractor _____

FIRST REPORTS

330 Ft. from N. Line

_____ Ft. from S. Line

990 Ft. from E. Line

_____ Ft. from W. Line

SECTION PLAT

			0

Location ✓

Rig up _____

Drilling and Remarks:

RECORD

Cased _____ in., _____ ft.

Sand _____

Gas _____

Oil _____

Total Depth _____

PRODUCTION

1st 24 hrs. Nat. _____

1st 24 hrs. after shot _____

Gas _____ Cu. Ft.

Dry Hole _____

Abandoned _____

Date

MAR 9 1932 CHAS. L. SHERWOOD Scout

no

z

z

Returned	<i>z</i>
Cards	<i>z</i>
Tracing	<i>z</i>
France Map	<i>X</i>
Scarborough Map	<i>X</i>
Moody Map	<i>X</i>
Scarborough Plat Book	
Moody Plat Book	

Ellsworth

55 KANSAS Sec. 12 Twp. 17 R. 10 W

Well No. 1 Stratman
Smith and Texas Company

Contractor

COMPLETED

SECTION PLAT

			0

330 Ft. from N. Line

Ft. from S. Line

490 Ft. from E. Line

Ft. from W. Line

Location

Rig up

Drilling and Remarks:

Patenting Prop
17 3/4 Bls 24 hours
on pump

RECORD

Cased in., ft.

Sand 3263-3285

Gas

Oil

Total Depth 3285

PRODUCTION

1st 24 hrs. Nat.

1st 24 hrs. after shot

Gas Cu. Ft.

Dry Hole

Abandoned

Date

JUN 15 1932

CHAS. L. SHERWOOD

192

Scout

no
over
1/2
1/2
Returned

Cards

Tracing

France Map

Scarborough Map

Moody Map

Scarborough Plat Book

Moody Plat Book