


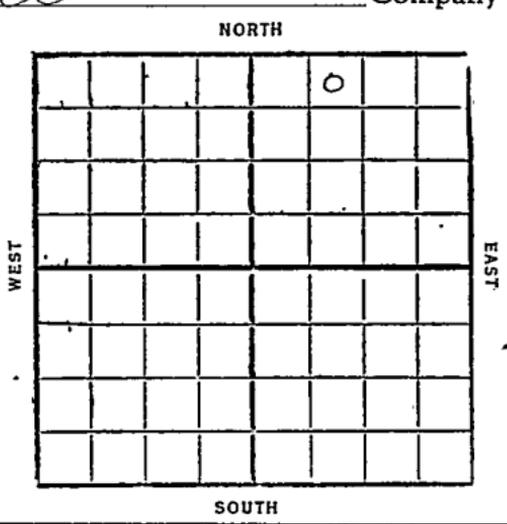

Map No. KANSAS Sec. 12 Twp. 17 R. 10<sup>W</sup>

Well No. 1-Stratman Farm  
Derby Oil Company

330 Ft. from N. Line  
\_\_\_\_ Ft. from S. Line  
\_\_\_\_ Ft. from E. Line  
990 Ft. from W. Line  
1931



Date	REPORT
12/30	Pldg rig
1932	Pldg
1/13	Perm 12"-211'
1/20	Wired 2340'
1/27	T.D. 3242 Prep to core
1/29	Top Green shale 3245'
	" Silic. lime 3253
	T.D. 3256 Cored lime
	show some saturation Perm 6"-3253
2/3	Coreing at 3257
2/10	T.D. 3283 1/2 Swab 64 bbl 10 hr Must
2/17	—
2/26	T.D. 3283 1/2 swab 14 bbl 1 hour shot 50 qt 3255-70 Clg out

3/2- T.D. 3283 $\frac{1}{2}$  lime  
swab 30 bbl first hr  
" 20 " second "  
" 35 " third "  
will shoot again

3/9- T.D. 3283 $\frac{1}{2}$   
shot 50 qt. 3270-81  
swab 30 bbl 1st hr  
" 20 " 2nd "

Old out

3/16- T.D. 3283 $\frac{1}{2}$   
Pump tubing  
No test

3/22- No report

3/30- Cased 8" 3253  
Silic. lime 3253-83 $\frac{1}{2}$

T.D. 3283 $\frac{1}{2}$

shot 50 qt 3255-70  
" 50 " 3270-81

Potential prod  
974 bbls

..Comp.

*Ellsworth*

55 **KANSAS** Map No. Sec. *12* Twp. *17* R. *10* <sup>W</sup>

Well No. *1* *Stratman*

*Derby Oil Co* Company

Contractor

**FIRST REPORTS**


**SECTION PLAT**

*330* Ft. from N. Line

..... Ft. from S. Line

..... Ft. from E. Line

*990* Ft. from W. Line

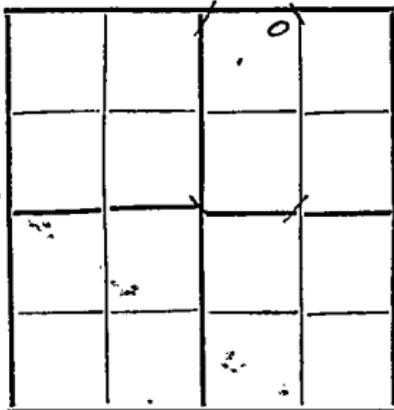

Location.....

Rig up.....

Drilling and Remarks:

*Blay Rig*

**RECORD**

Cased.....in., .....ft.

Sand.....

Gas.....

Oil.....

Total Depth.....

**PRODUCTION**

1st 24 hrs. Nat.....

1st 24 hrs. after shot.....

Gas.....Cu. Ft.

Dry Hole.....

Abandoned.....

Date

**DEC 30 1931**

**CHAS. L. SHERWOOD**

192.....Scout

*no was*  
*Prinzel*

Returned	<i>SP</i>
Cards	<i>SP</i>
Tracing	<i>SP</i>
France Map	<i>X</i>
Scarborough Map	<i>X</i>
Moody Map	<i>X</i>
Scarborough Plat Book	
Moody Plat Book	

Ellsworth

55

KANSAS

Map No. \_\_\_\_\_ Sec. 12 Twp. 17 R. 10 <sup>W</sup>

Well No. 1 Stratman

Derby Oil Co Company

Contractor

COMPLETED

SECTION PLAT

		0	

330 Ft. from N. Line

\_\_\_\_\_ Ft. from S. Line

\_\_\_\_\_ Ft. from E. Line

990 Ft. from W. Line

Location \_\_\_\_\_

Rig up \_\_\_\_\_

Drilling and Remarks:

Shot 50/3255-70

" 50/3270-81

Potential Prod

974 bbls.

RECORD

Cased 8" in., 3253 ft.

Sand 3253-83 1/2

Gas \_\_\_\_\_

Oil \_\_\_\_\_

Total Depth 3283 1/2

PRODUCTION

1st 24 hrs. Nat. \_\_\_\_\_

1st 24 hrs. after shot \_\_\_\_\_

Gas \_\_\_\_\_ Cu. Ft.

Dry Hole \_\_\_\_\_

Abandoned \_\_\_\_\_

Date

MAR 30 1932

CHAS. L. SHERWOOD

19

Scout

*no wall*

*[Signature]*

*[Signature]*

Returned	<i>[Signature]</i>
Cards	<i>[Signature]</i>
Tracing	<i>[Signature]</i>
France Map	<i>[Signature]</i>
Scarborough Map	<i>[Signature]</i>
Moody Map	<i>[Signature]</i>
Scarborough Plat Book	
Moody Plat Book	