

Form 51-5M-5-34-Palace

Map No. _____ Sec. 18 Twp. 1.1 R. 10

Well No. # 2 Strahman Farm

Smith & Ash & Tynes Company

NORTH

WEST

EAST

SOUTH


Location_____

Drilling Remarks

Rig Up

Drilling Remarks

RECORD

Cased_____in. _____ft.

Sand_____

Gas

Oil_____

Total Depth_____

PRODUCTION

1st 24 hrs. Nat.-----

1st 24 hrs. after shot_____

Gas _____cu. ft._____

Dry Hole.....

Abandoned_____

Ellsworth

Map No. KANSAS Sec. 12 Twp. 17 R. 10^W


Well No. 2 Stratman Farm
Smith & Ash & Taylor Company

990 Ft. from N. Line

 Ft. from S. Line

990 Ft. from E. Line

 Ft. from W. Line

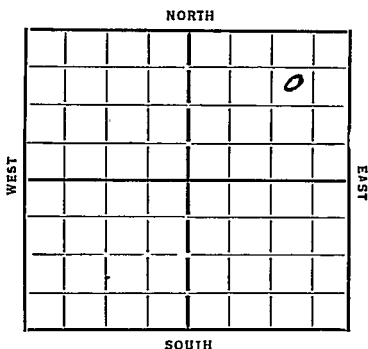

Date 12/25

REPORT

<u>1/23</u>	<u>Location</u>	
<u>1/31</u>	<u>Rgn</u>	
<u>2/7</u>	<u>alg 355</u>	
<u>2/14</u>	<u>" 960</u>	<u>12" 365</u>
<u>2/21</u>	<u>" 1820</u>	
<u>2/28</u>	<u>" 2330</u>	<u>10" 1872</u>
<u>3/7</u>	<u>" 2925</u>	
<u>3/14</u>	<u>8" 3052 6" 3198 T 7 3275</u>	
<u>3/20</u>	<u>Siliceous 3308 T 7 3375</u>	
	<u>7 & A.</u>	

ABANDONED

KANSAS

Map No. 55 Sec. 12 Twp. 17 R. 10WWell No. 2-StratmanSmith & Ash & Turps Company

Contractor

FIRST REPORTS**SECTION PLAT**990 Ft. from N. Line

..... Ft. from S. Line

990 Ft. from E. Line

..... Ft. from W. Line

			0

Location.....

Rig up.....

Drilling and Remarks:

RECORD

Cased.....in.,ft.

Sand.....

Gas.....

Oil.....

Total Depth.....

PRODUCTION

1st 24 hrs. Nat.....

1st 24 hrs. after shot.....

Gas.....Cu. Ft.

Dry Hole.....

Abandoned.....

Date

1-23-35 192**ORVAL MANNSCHRECK**
Scout

[Handwritten scribbles and lines]

Returned	<i>[Signature]</i>
Cards	<i>[Signature]</i>
Tracing	<i>[Signature]</i>
Franc	<i>[Signature]</i>
Sec.	<i>[Signature]</i>
...	<i>[Signature]</i>
...	<i>[Signature]</i>
...	<i>[Signature]</i>

KANSAS

Map No. 55 Sec. 12 Twp. 17 R. 10W

Well No. 2 - Stratman

Smith & Ash & Tapes Company

Contractor


ABANDONED SECTION PLAT

990 Ft. from N. Line

Ft. from S. Line

990 Ft. from E. Line

Ft. from W. Line

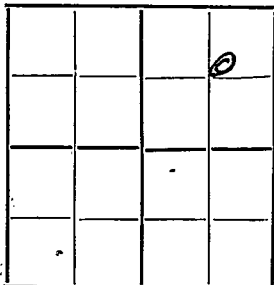

Location

Rig up

Drilling and Remarks:

10 & A.

RECORD

Cased in, ft.

Sand siliceous 3308

Gas

Oil

Total Depth 3375

PRODUCTION

1st 24 hrs. Nat.

1st 24 hrs. after shot

Gas Cu. Ft.

Dry Hole

Abandoned

Date

ORVAL MANNSCHRECK

3-20-35

192

Scout

no
more

Returned	<i>CD</i>
Cards	<i>CD</i>
Tracing	<i>ms</i>
France Map	
Scarborough Map	<i>X</i>
Moody Map	<i>X</i>
Scarborough Plot Book	
Moody Plot Book	