

Ellsworth

Form 252-A
5M 4-32 MPC

KANSAS

Map No. _____ Sec. 12 Twp. 17 R. 10W

Well No. 2 Stratman Farm


Derby Oil Company

330 Ft. from N. Line

_____ Ft. from S. Line

_____ Ft. from E. Line

330 Ft. from W. Line

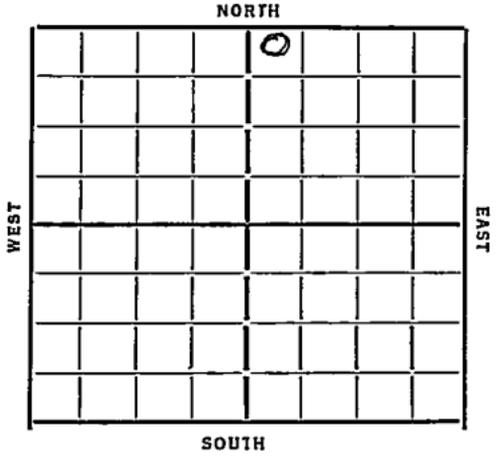

Date
1933

REPORT

7/12 Cellar

7/19 —

7/26 Rig

8/2 same

8/9 —

8/16 —

8/23 Reg'd Rotary

8/30 July 15 65

9/6 12' at 220 - Reg 2660

9/13 Top Sil 3248 - TD 3252 -
Cen 6" 3248 - RUST

9/20 swab 11 bbls per hr treated 1000 gal acid
no test

9/29 shot 40 gal - 12 bbls per hour
no test

10/5 165 - bbls 24 hrs acidize again

10/11 —

10/18 Silveaux 3248' T.D. 3252
312 bbls Oil
COMPLETED

Map No. _____ Sec. 12 Twp. 17 R. 10W

Well No. 55-2-Stratman

Derby Oil Company

Contractor _____

SECTION PLAT

330 Ft. from N. Line

_____ Ft. from S. Line

_____ Ft. from E. Line

330 Ft. from W. Line

		○	

FIRST REPORTS

Location _____

Rig up _____

Drilling and Remarks:

cellar

RECORD

Cased _____ in., _____ ft.

Sand _____

Gas _____

Oil _____

Total Depth _____

PRODUCTION

1st 24 hrs. Nat. _____

1st 24 hrs. after shot _____

Gas _____ Cu. Ft.

Dry Hole _____

Abandoned _____

Date

7/17/33 192 Orval Mannscheck Scout

no wall map

Returned	
Cards	<i>[initials]</i>
Tracing	<i>[initials]</i>
France Map	<i>[initials]</i>
Scarborough Map	<i>[initials]</i>
Moody Map	<i>[initials]</i>
Scarborough Plat Book	
Moody Plat Book	

Elesworth
 Map No. 55 Sec. 12 Twp. 17 R. 10W
 Well No. 2-Stratman
Derby oil Company
 Contractor

COMPLETED

SECTION PLAT

330 Ft. from N. Line
 Ft. from S. Line
 Ft. from E. Line
330 Ft. from W. Line

		0	

Location.....
 Rig up.....
 Drilling and Remarks:

*312 bbls
oil*

RECORD

Cased..... in., ft.
 Sand *siliceous 3248*
 Gas.....
 Oil.....
 Total Depth 3252

PRODUCTION

1st 24 hrs. Nat.....
 1st 24 hrs. after shot.....
 Gas..... Cu. Ft.
 Dry Hole.....
 Abandoned.....

Date

10-18-33 ₁₉₂ *O'Mannick* Scout

Dr. J. W. Wells
ms. wells

Returned	
Cards	<i>W. J. Wells</i>
Tracing	<i>W. J. Wells</i>
France Map	<i>X</i>
Scarborough Map	<i>X</i>
Moody Map	<i>X</i>
Scarborough Plat Book	
Moody Plat Book	