KANSAS

Form 51—5M—7-40—Palace


Ellsworth

Section 12 Township 17 Range 10-W

Well No. #1 Grounds

Company Phillips

Bloomer Pool

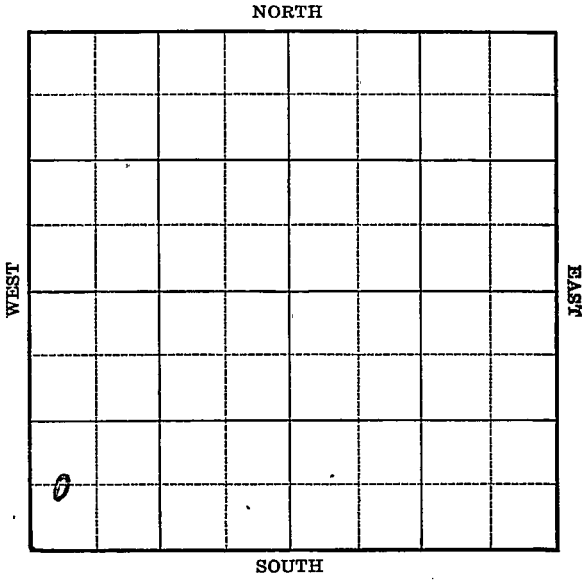

FORM 252-A 5M 1-41 PETROL KANSAS Ellsworth

Sec. 12 Twp. 17 R. 10-W

Well No. #1 Grounds Farm

Phillips Company


(Bloomer)

____ Ft. from N. Line

660 Ft. from S. Line

____ Ft. from E. Line

330 Ft. from W. Line

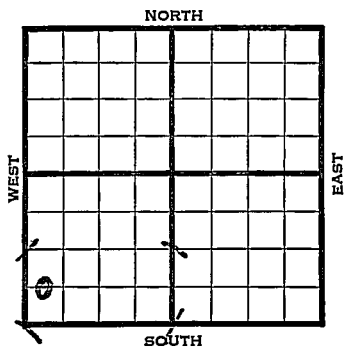

Elev. 1807

1941	REPORT
3/26	8" - 465' WOC.
4/2	Drlg. 2815'
4/10	Arb. 3272-80' T.D. 4" - 3273'
	RUST.
4/18	T.D. 3280' 500 acid.
	Swab 136 bbls. oil 5 hours.
4/24	" " " "
5/1	1000 acid. Pump 261 oil 18
	hours.
5/7	Arb. 3272'
	4" - 3273'
	T.D. 3280'
	1000 acid.
	Echometer potential 998 bbls.
	37.1 Gravity
	COMPLETED

Form 26—200 Bks.—1-40—Palace Ellsworth KANSAS

Map No. 55 Sec. 12 Twp. 17 R. 10W

Well No. 1 Grounds

Phillips Company

FIRST REPORT Contractor

C W L SW SW

_____ Ft. from N. Line


660 Ft. from S. Line

_____ Ft. from E. Line

330 Ft. from W. Line

BLOOMER POOL

SECTION PLAT

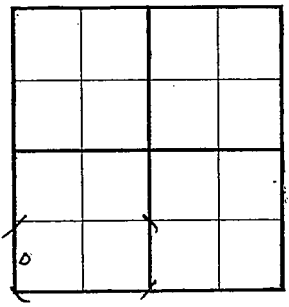

Location _____

Rig up _____

Drilling and Remarks:

8" - 465

WOC

RECORD

Cased _____ in., _____ ft.

Sand _____

Gas _____

Oil _____

Total Depth _____

PRODUCTION

1st 24 hrs.-Nat. _____

1st 24 hrs. after shot _____

Gas _____ Cu. Ft.

Dry Hole _____

Abandoned _____

Date

MAR 26 1941 19 _____

S. I. LEWIS Scout

Form 26—200 Bks.—1-40—Palace Ellsworth KANSAS

Map No. 55 Sec. 12 Twp. 17 R. 10W

Well No. 1 Grounds

Phillips Company

COMPLETED Contractor

C W L SW SW

____ Ft. from N. Line


660 Ft. from S. Line

____ Ft. from E. Line

330 Ft. from W. Line

BLOOMER POOL

SECTION PLAT

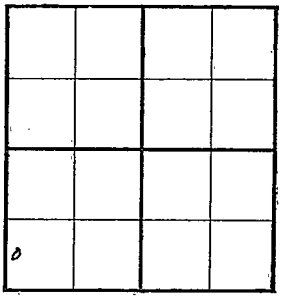

Location ____

Rig up ____

Drilling and Remarks:

Cr 3272.
4" @ 3273
1000 cmt
Echo Pd 998

37 1/2 Gr.

RECORD

Cased ____ in., ____ ft.

Sand ____

Gas ____

Oil ____

Total Depth 3280

PRODUCTION

1st 24 hrs. Nat. ____

1st 24 hrs. after shot ____

Gas ____ Cu. Ft.

Dry Hole ____

Abandoned ____

Date

MAY 7 1941 19____ S. J. LEWIS Scout