

KANSAS


FORM 51 5M PETROL

Ellsworth

Section 12 Township 17 Range 10-W

Well No. #1 Grounds

Company Vickers

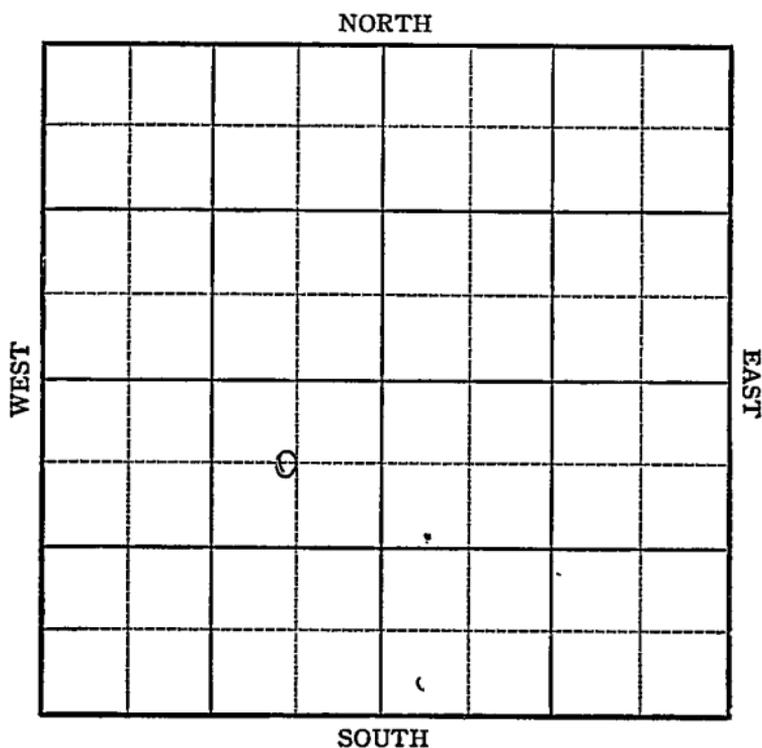


Sec. 12 Twp. 17 R. 10-W

Well No. #1 Grounds Farm

Vickers Company

NORTH

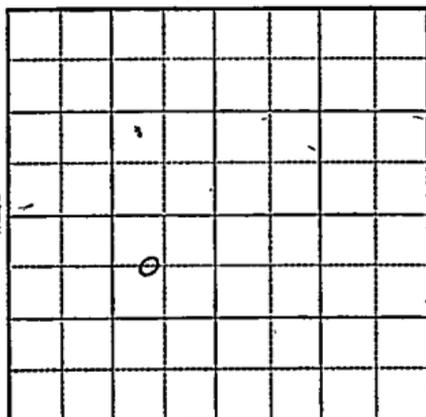

660 Ft. from N. Line

_____ Ft. from S. Line

760 Ft. from E. Line

_____ Ft. from W. Line

Elev. 1796

1943

R E P O R T

10/27 Location

11/3 Surface hole

11/10 10" @ 220
Lans 2900
Arb 3258
T.D. 3263
un Csg.

11/17 5" @ 3263
TD 3270'
80' fluid

11/24 5" @ 3263'
Arb. 3258
2500 Acid
Pump 90 Pot.
Grav. 40.1°
TD 3283'

COMPLETED

Ellsworth

KANSAS

Map No. 55 Sec. 12 Twp. 17 R. 10W

Well No. 1 Grounds

Vickers Company

FIRST REPORT Contractor

C NE SW

SECTION PLAT

660 Ft. from N. Line

_____ Ft. from S. Line

760 Ft. from E. Line

_____ Ft. from W. Line

-			
	o		

Bloomer Pool

Location x

Rig up _____

Drilling and Remarks:

RECORD

Cased _____ in., _____ ft.

Sand _____

Gas _____

Oil _____

Total Depth _____

PRODUCTION

1st 24 hrs. Nat. _____

1st 24 hrs. after shot _____

Gas _____ Cu. Ft.

Dry Hole _____

Abandoned _____

Date

OCT 27 1943 19

S. J. LEWIS Scout

