

KANSAS


Ellsworth

FORM 51 5M 1-42 PETROL

Section 12 Township 17 Range 10-W

Well No. #2 Grounds _____

Company Vickers _____

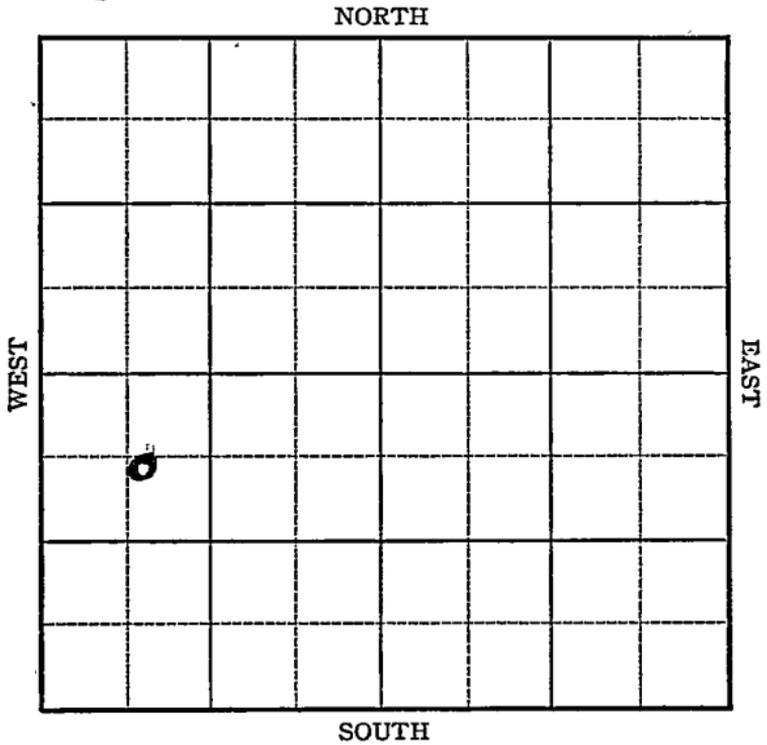

Sec. 12 Twp. 17 R. 10-W

Well No. #2 Grounds Farm

Vickers Company


660 Ft. from N. Line

_____ Ft. from S. Line

_____ Ft. from E. Line

760 Ft. from W. Line

Elev. 1798

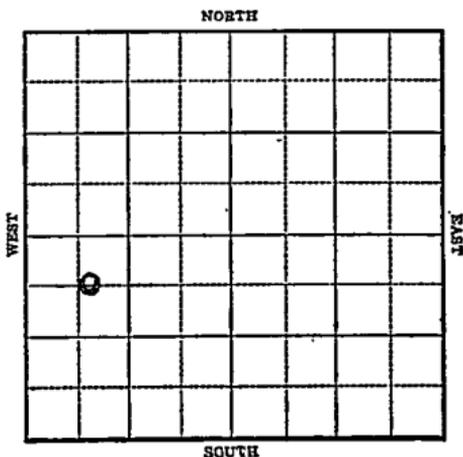

1943

R E P O R T

11/10 Location
 11/17 Drlg. 250'
 11/24 Drlg 2755'
 12/1 10" @ 216'
 Lans 2912
 Arb 3250
 5" @ 3252
 Drlg 3263 no shows
 12/8 TD 3275- 500 Acid
 10 qts CO
 12-15 4000 acid
 Swb 140 oil in 4 hours
 12/22 " " "
 12/29 " " "

1944

1/5 Arb 3250
 5" @ 3252
 TD 3275
 4000 acid
 Echo Pot. 2692 oil & 7% water
 Gravity 40.8

COMPLETED

KANSAS
Map No. 55 Sec. 12 Twp. 17 R. 10WWell No. 2 GroundsVickers CompanyFIRST REPORT Contractor

C NW SW

SECTION PLAT

660 Ft. from N. Line Ft. from S. Line Ft. from E. Line760 Ft. from W. Line

o			

Bloomer PoolLocation XRig up

Drilling and Remarks:

RECORD

Cased in., ft.Sand Gas Oil Total Depth

PRODUCTION

1st 24 hrs. Nat. 1st 24 hrs. after shot Gas Cu. Ft.Dry Hole Abandoned

Date

NOV 10 1943 19S. J. LEWIS Scout

Map No. 55 Sec. 12 Twp. 17 R. 10W

Well No. 2 Grounds

Vickers Company

COMPLETED Contractor

C NW SW

SECTION PLAT

660 Ft. from N. Line

_____ Ft. from S. Line

_____ Ft. from E. Line

76.0 Ft. from W. Line

o			

Bloomer Pool

Location _____

Rig up _____

Drilling and Remarks:

CR 3250
5" CR 3252
4000 acid
EC 100 P 2692 oil
7 7/8 W.
405 H

RECORD

Cased _____ in., _____ ft.

Sand _____

Gas _____

Oil _____

Total Depth 3225

PRODUCTION

1st 24 hrs. Nat. _____

1st 24 hrs. after shot _____

Gas _____ Cu. Ft.

Dry Hole _____

Abandoned _____

Date

JAN 5 1944 19

S. J. LEWIS Scout