

KANSAS


Ellsworth

FORM 51 5M PETROL

Section 12 Township 17 Range 10-W

Well No. #1
#2 Phelan

Company Duwe Harris

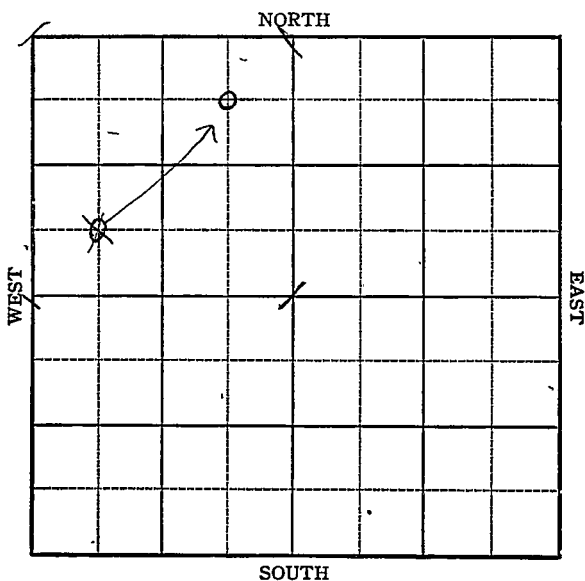


KANSAS

Ellsworth

Sec. 12 Twp. 17 R. 10-WWell No. #1 ~~#2~~ Phelan Farm

Duwe-Farris

Company

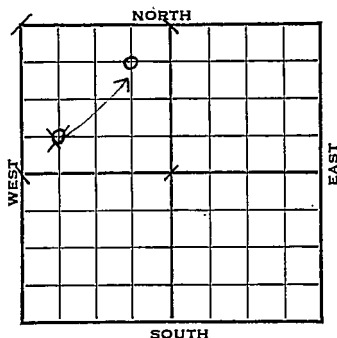660 Ft. from N. Line660 Ft. from S. Line660 Ft. from E. Line660 Ft. from W. Line

1943

REPORT

8/18 Location

8/25 8" @ 180'
Drlg. 510'9/1 Drlg. 2930
Lans 2951
Drlg. 29829/8 Arb 3270-82. T.D.
Run 5"9/15 5" @ 3272
T.D. 3293
Temp Ot. 49

9/2 " " "

9/29 " " "

10/6 " " "

10/13 T.D. 3266-50" acid

10/20 " " "

10/27 Pump 200 bbls oil 24 hrs.

11/3 " " " "

OVER

1943

11/10 T.D. 3299-1000 acid

Pump 9 oil per hr & water

PB

11/17 Arb 3270

5" @ 3272

1000 acid

Pump 250 Pot.

T.D. 3299'

COMPLETED

KANSAS


Map No. 55 Sec. 12 Twp. 17 R. 10WWell No. 2 PhelanDuwe - Farris CompanyFIRST REPORT Contractor

C SW NW

 Ft. from N. Line660 Ft. from S. Line Ft. from E. Line660 Ft. from W. Line

BLOOMER POOL

SECTION PLAT

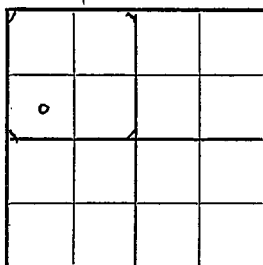Location XRig up

Drilling and Remarks:

RECORD


Cased in., ft.Sand Gas Oil Total Depth

PRODUCTION

1st 24 hrs. Nat. 1st 24 hrs. after shot Gas Cu. Ft.Dry Hole Abandoned

Date

AUG 1 8 1943 19 S. J. LEWIS Scout

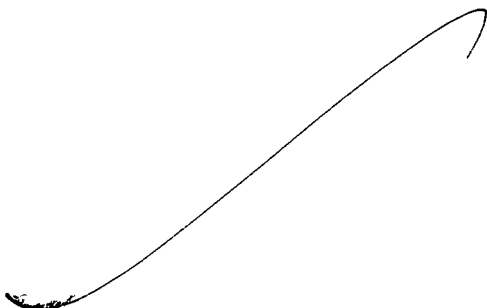

Misc Small Maps	<i>Ona</i>
Cards	<i>Boat</i>
Tracing	<i>ME</i>
France Map	<i>Map</i>
Scarborough Map	<i>Map</i>
Moody Map	<i>ME</i>
Geological Des.	
dv lat Book	

KANSAS

Map No. 55 Sec. 12 Twp. 17 R. 10WWell No. 2 PhelanDuwe - Farris


Company

CORRECTION

Contractor

C NE NW

SECTION PLAT

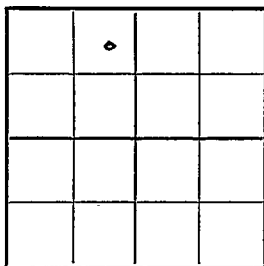660 Ft. from N. Line

Ft. from S. Line

660 Ft. from E. Line

Ft. from W. Line

BLOOMER POOL

Location

Rig up

Drilling and Remarks:

Reported

C SW NW

RECORD

Cased _____ in., _____ ft.

Sand _____

Gas _____

Oil _____

Total Depth _____

PRODUCTION

1st 24 hrs. Nat. _____

1st 24 hrs. after shot _____

Gas _____ Cu. Ft.

Dry Hole _____


Abandoned _____

Date

AUG 25 1943

19

S. J. LEWIS Scout

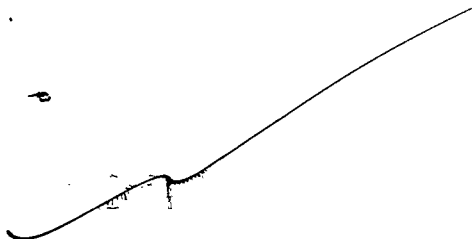

Misc Small Maps	<i>Onya</i>
Cards	<i>Burt</i>
Tracing	<i>W.E.L.</i>
France Map	<i>[Signature]</i>
Scarborough Map	<i>[Signature]</i>
Moody Map	<i>W.E.L.</i>
Geological Dept	<i>[Signature]</i>
Moody Flat Book	

KANSAS

Map No. 55 Sec. 12 Twp. 17 R. 10WWell No. 1 PhelanDuwe-Farris CompanyCORRECTION Contractor

C NE NW

660 Ft. from N. Line Ft. from S. Line Ft. from E. Line660 Ft. from W. Line

SECTION PLAT

	o		

Bloomer Pool

Location Rig up

Drilling and Remarks:

Reported as
#2 Phelan

RECORD

Cased in., ft.Sand Gas Oil Total Depth

PRODUCTION

1st 24 hrs. Nat. 1st 24 hrs. after shot Gas Cu. Ft.Dry Hole Abandoned

Date

OCT 27 1943 19 S. J. LEWIS Scout

Misc. Small Maps

Cards

The

Franklin Map

Scott. Rough Map

Pierce Map

Geological Dept.

Pierce Plat Book

Ona

Beet

23 27 28 29

1

1

1

1

KANSAS

Map No. 55 Sec. 12 Twp. 17 R. 10WWell No. 1 Phelan

Duwe & Ferris

Company

COMPLETED

Contractor

C NE NW

SECTION PLAT

	o		

660 Ft. from N. Line Ft. from S. Line Ft. from E. Line660 Ft. from W. Line

Bloomer Pool

Location Rig up

Drilling and Remarks:

*Ar 83270**5-03272**1000 acid**Pump 250 P.D.**426 ft*

RECORD

Cased in., ft.Sand Gas Oil Total Depth 3299

PRODUCTION

1st 24 hrs. Nat. 1st 24 hrs. after shot Gas Cu. Ft.Dry Hole Abandoned

Date

NOV 17 1943

19

S. J. LEWIS

Scout

Misc. Small Maps *Done*
Cards *Madge*
Tracing *MEL*
France Map ☒
Scarborough Map *MEL*
Pierce Map *MEL*
Geological Dept. *MEL*
Pierce Plat Book