


Ellsworth

Form 51-5M-11-31-Palace

Map No. KANSAS Sec. 12 Twp. 17 R. 10ⁿ

Well No. 1-Phelan Farm

Continental Oil Company

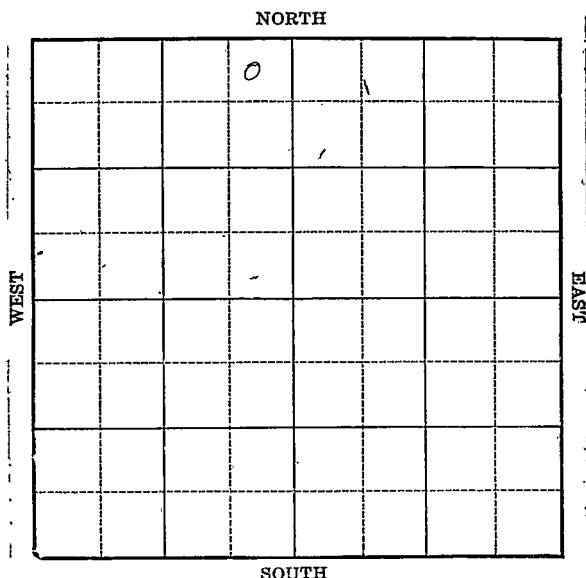

Location _____

Drilling Remarks _____

RECORD

Cased _____ in. _____ ft.

Sand _____

Gas _____

Oil _____

Total Depth _____

Rig Up _____

Drilling Remarks _____

PRODUCTION

1st 24 hrs. Nat. _____

1st 24 hrs. after shot _____

Gas _____ cu. ft.

Dry Hole _____

Abandoned _____


Map No. KANSAS Sec. 12 Twp 17 R. 10^W
Well No. 1- Chelan Farm
Continental Oil Company

330 Ft. from N. Line

 Ft. from S. Line

330 Ft. from E. Line

19.33 Ft. from W. Line

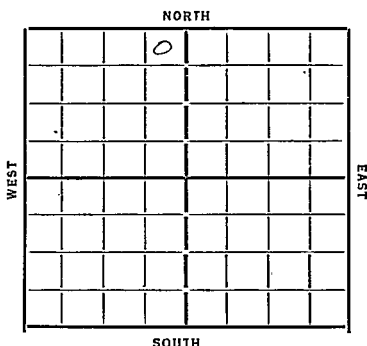

Date

REPORT

2/15	<u>Doc</u>
2/22	<u> </u>
3/4	<u> </u>
3/8	<u> </u>
3/10	<u> </u>
3/22	<u>Bldg Rig</u>
3/29	<u>Spudding</u>
4/4	<u>20"-76' 15" 360' 12"-516 dly 675'</u>
4/12	<u>dly 1785'</u>
4/19	<u>" 2190'</u>
4/26	<u>" 2830'</u>
5/4	<u>show oil 3021-30 ify 3182</u>
5/10	<u>8" 3145 Top Cong 3243 6" 3257</u>
	<u>Siliceous 3255-93' 1400' Oil in hole</u>
5/17	<u>Treat 1000 gal acid saw ab 5 lbs</u>
	<u>per hr.</u>
5/24	<u>No show test</u>
6/1	<u> </u>

(over)

6/7 Top Siliceous 3250
treated 1000 gallon acid
Swab 90 bbls oil. +
3 bbls water per day

COMPLETED

Ellsworth

W

55 KANSAS

Map No. _____ Sec. 12 Twp. 17 R. 10

Well No. 1 - Phelan

Continental Oil Co Company

Contractor

FIRST REPORTS

330 Ft. from N. Line

_____ Ft. from S. Line

330 Ft. from E. Line

_____ Ft. from W. Line

SECTION PLAT

		o	

Location ✓

Rig up

Drilling and Remarks:

RECORD

Cased ⁵ in., _____ ft.

Sand _____

Gas _____

Oil _____

Total Depth _____

PRODUCTION

1st 24 hrs. Nat. _____

1st 24 hrs. after shot _____

Gas _____ Cu. Ft.

Dry Hole _____

Abandoned _____

Date

FEB 15 1933

CHAS. L. SHERWOOD

192

Scout

no wall map
France

Returned	_____
Cards	_____
Tracing	_____
France Map	_____
Scarborough Map	_____
Moody Map	_____
Scarborough Flat Book	_____
Moody Flat Book	_____

Ellsworth

Map No. Sec. 12 Twp. 17 R. 10WWell No. 1-PhilonContinental Oil Co Company

Contractor


SECTION PLAT

330 Ft. from N. Line

..... Ft. from S. Line

330 Ft. from E. Line

..... Ft. from W. Line

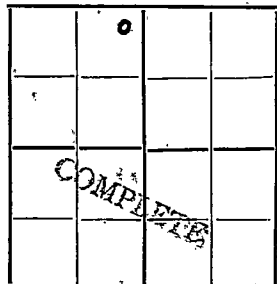

Location

Rig up

Drilling and Remarks:

Top Siliceous
3250Treated 1000 gal
acidSwab 90 bbls oil
+ 3 Bbls water per day

RECORD

Cased in., ft.

Sand

Gas

Oil

Total Depth 3293

PRODUCTION

1st 24 hrs. Nat.

1st 24 hrs. after shot

Gas Cu. Ft.

Dry Hole

Abandoned

Date

6/7/33 192 Oval Mannschuck Scout

no wall map
Small map

Returned	
Cards	<i>[initials]</i>
Tracing	<i>[initials]</i>
France Map	X
Scarborough Map	X
Moody Map	X
Scarborough Plat Book	
Moody Plat Book	