

Ellsworth

Section 12 Township 17 Range 10WWell No. #2 PhelanCompany Ash-Mar Drlg.

		0					

NORTH

WEST

EAST

SOUTH

Ellsworth KANSAS ✓


Sec. 12 Twp. 17 R. 10 WWell No. # 2 Phelan FarmAsh-Mar Drlg. CompanyAsh-Mar Contractor**Stoltenberg Pool**

Ft. from N. Line

330 Ft. from S. Line990 Ft. from E. Line

Ft. from W. Line

SW SE NW

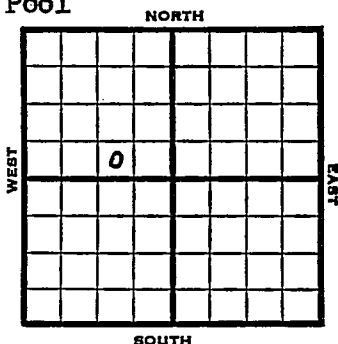

1953

Elev 1799'

REPORT

5/6 MIR


5/21 8" @ 186 Anhy 540' Arb. 3258
RTD 3281' 5" @ 3275

5/28 N.R.

6/10 Spud 5-6-53
D & A
TD 3288'
8" @ 186'
Anhy 540, Arb 3258,
TD 3281'
5" @ 3275'
CO to 3281'
500 A S/ 1½ boph dec. to 3/4 boph
after 10 hr. 1500 A PB 3275
19/ 3265-71 DD 3288 PB 3271
18/3265-71 500 A 1¼ bwph
D & A

ABANDONED

J. G. McGEHEE

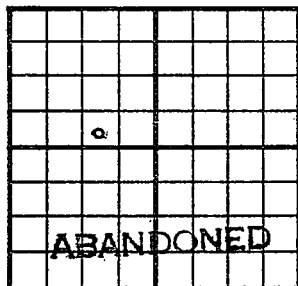County Ellsworth State KansasSec. 12 (Blk. Twp.) 17 (Sur. Rge.) 10W Map No.Operator Ash-Mar Drlg.Well No. 2 Farm PhelanElev. 1799 Location SW SE NW330 Ft. From S Line NW990 Ft. From E Line Quarter

1st. Report

Completion JUN 10 1953Remarks Stoltenberg PoolAsh-Mar - Contr.Spudding Date 5-6-53Drlg. Data D & A TD 32888" @ 186 Anhy 540 Arb. 3258TD 3281 5" @ 3275 CO to 3281 500 AS/ 1½ boph dec. to 3/4 boph after 10 hr.1500 A PB 3275 19/ 3265-71 DD 3288PB 3271 18/ 3265-71 500 A 14 bwphD & A