

Alsworth


Form 51-5M-11-31-Palace

Map No. KANSAS Sec. 12 Twp. 17 R. 10^w

Well No. 1- Bloog Farm

Derby Oil & Coal Company

NORTH

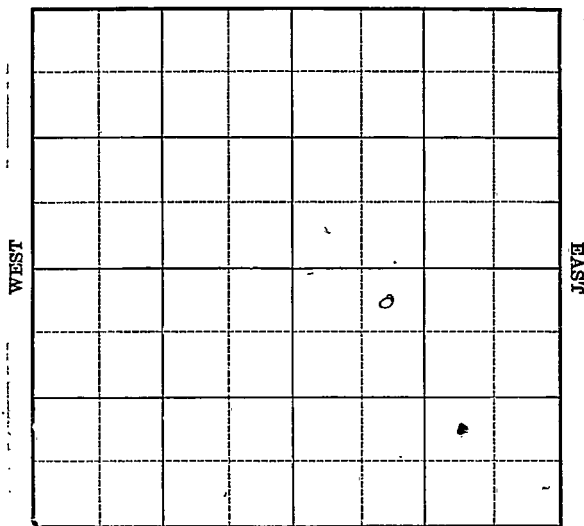

SOUTH

Location

Drilling Remarks

Rig Up

Drilling Remarks

RECORD

Cased in. ft.

Sand

Gas

Oil

Total Depth

PRODUCTION

1st 24 hrs. Nat.

1st 24 hrs. after shot

Gas cu. ft.

Dry Hole

Abandoned

Map No. KANSAS Sec. 12 Twp. 17 R. 10^W

Well No. 1- Bloog Farm
Derby Oil & Fuel Company


330 Ft. from N. Line

_____ Ft. from S. Line

_____ Ft. from E. Line

990 Ft. from W. Line

1932

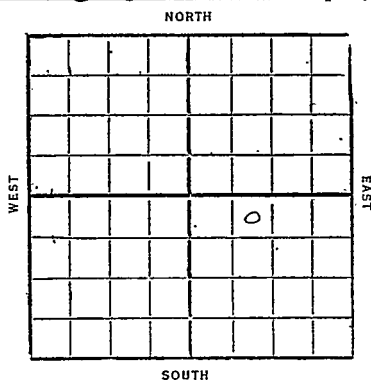

Date

REPORT

10/12 Bldg rotary rig
10/19
10/26 12" 211
drlg 2300'
11/2 " 3252'
11/9 Top Silic 3303-09
small show oil
Cem 6"-3304 Rust
11/16 Cased 6"-3304
Silic line 3303-29
TD 3329
shot 5 qt 3304-09
show oil & HFW
Abandoned

Ellsworth

55 KANSAS

W

Map No. Sec. 12 Twp. 17 R. 10

Well No. 1

Derby Oil Co. & Co. Company

Contractor

FIRST REPORTS


SECTION PLAT

330 Ft. from N. Line

Ft. from S. Line

Ft. from E. Line

990 Ft. from W. Line

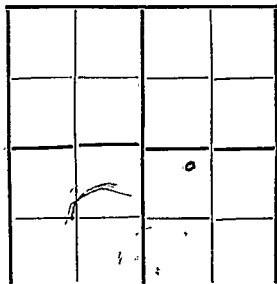

Location

Rig up

Drilling and Remarks:

Block Rotary Rig

RECORD

Cased in., ft.

Sand

Gas

Oil

Total Depth

PRODUCTION

1st 24 hrs. Nat.

1st 24 hrs. after shot

Gas Cu. Ft.

Dry Hole

Abandoned

Date

OCT 12 1932

CHAS. L. SHERWOOD

Scout

Ellsworth

55 KANSAS

W/

Map No. Sec. 12 Twp. 17 R. 10

Well No. 1

Derby Oil Co & Co Company

Contractor

COMPLETED

SECTION PLAT

330 Ft. from N. Line

..... Ft. from S. Line

..... Ft. from E. Line

990 Ft. from W. Line

		o	

ABANDONED

Location

Rig up

Drilling and Remarks:

Shot 5/3304-09

Show Oil

J H F

RECORD

Cased 6 in., 3304 ft.

Sand 3303-3329

Gas

Oil

Total Depth 3329

PRODUCTION

1st 24 hrs. Nat.

1st 24 hrs. after shot

Gas Cu. Ft.

Dry Hole ✓

Abandoned ✓

Date

NOV 16 1932 CHAS. L. SHERWOOD

192

Scout