KANSAS


Ellsworth

FORM 51 5M BRIX

Section 12 Township 17 Range 10W

Well No. #1, Ploog

Company Bay Pet.

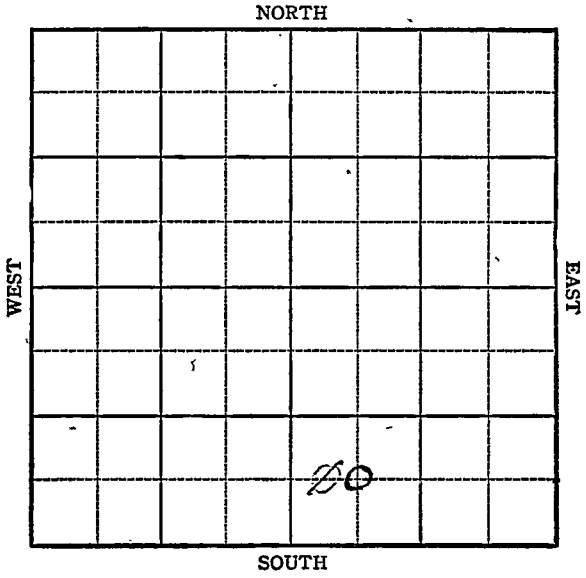

FORM 252-A
SWS-STATE PETROL

KANSAS

Sec. 12 Twp. 17 R. Ellsworth 10W

Well No. #1 Ploog Farm

Bay Pet. Company


Bloomer

_____ Ft. from N. Line

660 Ft. from S. Line

_____ Ft. from E. Line

~~660~~ ~~330~~ Ft. from W. Line

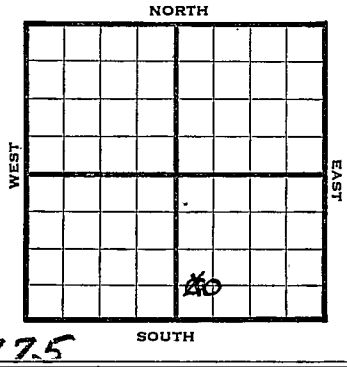

Elev. 1775

1944	REPORT
5/24	8" @ 399' Anhy 509' Drlg. @ 1270'
5/31	Drlg. 2920
6/7	Lans 2900 Cong. 3223 Arb. 3230-33 TD Sat. 5" @ 3231 RUST
6/15	TD 3245 150 acid No help
6/21	" " "
6/28	TD 3250 1000 acid SWB 7 oil per hr
7/12	TD 3250 1000 acid Swb 7 oil per hr 175
7/19	Estimate ~~174~~ oil a day SW
7/26	" " " " " "
8/2	" " " " " "
8/9	" " " " " "
8/16	" " " " " "

OVER

1944

8/23 Arb 3230
5" @ 3231
2500 acid
Pump 125 Potl - Gravity 42
TD 3250

COMPLETED

FORM 26 200 BKS 2-44 PETROL

KANSAS

Pool Name Bloomer

Map No. Sec. 12 Twp. 17 R. 10W


Well No. 1 Ploog

Bay Pet. Company

FIRST REPORT Contractor

C W L SW SE

SECTION PLAT

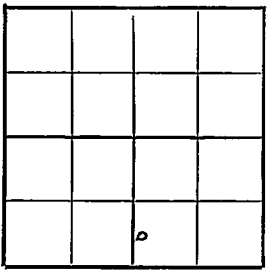

Ft. from N. Line

660 Ft. from S. Line

Ft. from E. Line

330 Ft. from W. Line

Ellsworth County

Location

Rig up

Drilling and Remarks:

8" - 399
Anhy 509
1270

RECORD

Cased in., ft.

Sand

Gas

Oil

Total Depth

PRODUCTION

1st 24 hrs. Nat.

1st 24 hrs. after shot

Gas Cu. Ft.

Dry Hole

Abandoned

Date

MAY 24 1944 19 S. J. LEWIS Scout

Misc. Small Maps
Cards
Tracing
France Map
Scarborough Map
Pierce Map
Geological Dept.
Plat Book

FORM 26 200 BKS. 2-44 PETROL

Pool Name Bloomer

Map No. 55 Sec. 12 Twp. 17 R. 10W


Well No. 1 Ploog

Bay Pet. Company

CORRECTION Contractor

C SW SE

SECTION PLAT

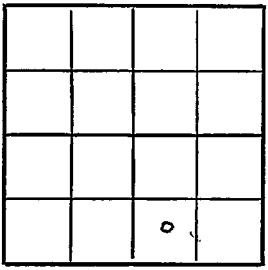

____ Ft. from N. Line

660 Ft. from S. Line

____ Ft. from E. Line

660 Ft. from W. Line

Ellsworth County

Location

Rig up

Drilling and Remarks:

Reported
C W L SW SE

RECORD

Cased ____ in., ____ ft.

Sand

Gas

Oil

Total Depth

PRODUCTION

1st 24 hrs. Nat.

1st 24 hrs. after shot


Gas ____ Cu. Ft.

Dry Hole

Abandoned

Date

JUN 14 1944 19 S. J. LEWIS Scout

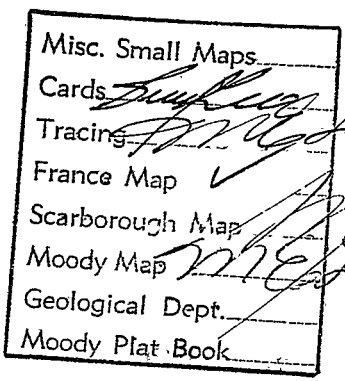
Misc. Small Maps
Cards
Tracing
France Map
Scarborough Map
Moody Map
Geological Dept.
Moody Plat Book

FORM 26 200 BKS. 2-44 PETROL

Pool Name Bloomer

Map No. 35 Sec. 12 Twp. 17 R. 10W


Well No. 1 Ploog

Bay Pet. Company

COMPLETED Contractor

C SW SE

SECTION PLAT

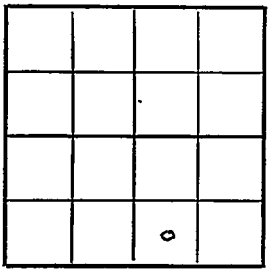

____ Ft. from N. Line

660 Ft. from S. Line

____ Ft. from E. Line

660 Ft. from W. Line

Ellsworth County

Location

Rig up

Drilling and Remarks:

Cr 3230

5' @ 3231

2500 acid

Pump 125 BF

42 2 Gr

RECORD

Cased ____ in., ____ ft.

Sand

Gas

Oil

Total Depth 3250

PRODUCTION

1st 24 hrs. Nat.

1st 24 hrs. after shot

Gas ____ Cu. Ft.


Dry Hole

Abandoned

Date

AUG 23 1944 19

S. J. LEWIS Scout

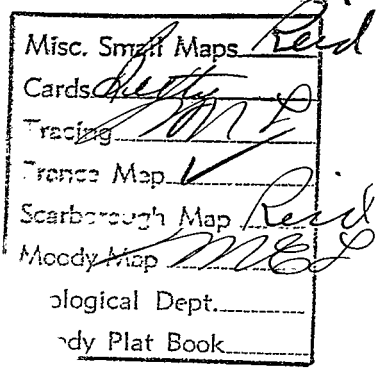
Misc. Small Maps Reid
Cards Petty
Tracing MNE
Trance Map V
Scarborough Map Reid
Moody Map MNE
ological Dept.
dy Plat Book