
KANSAS Ellsworth

FORM 51 5M BRIX

Section 12 Township 17 Range 10W

Well No. #2, Ploog.

Company Bay Pet.

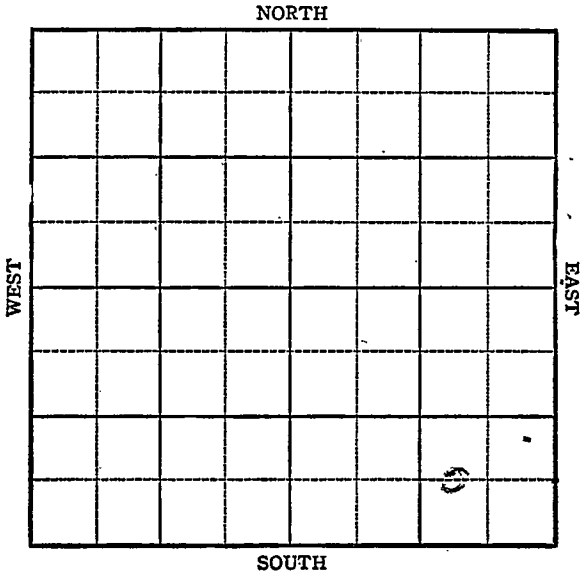

FORM 252-A
5M 3-44 PETROL KANSAS

Ellsworth County

Sec. 12 Twp. 17 R. 10W

Well No. #2 Ploog Farm

Bay Pet. Company


Bloomer

_____ Ft. from N. Line

660 Ft. from S. Line

990 Ft. from E. Line

_____ Ft. from W. Line

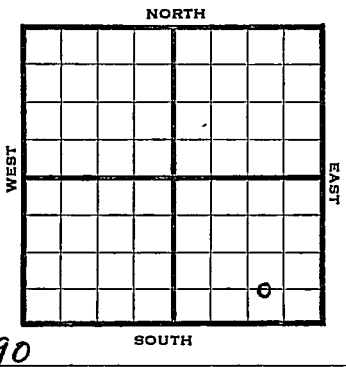

Elev. 1790

1944	REPORT
7/12	Rotary
7/19	8" @ 409 Drlg 1480
7/26	Anhy 529 Lans.2912 Drlg. 3022.
8/2	Cong 3227 Arb 3235 Td 3240 5" @ 3238 RUST
8/9	TD 3243 SO Re-cement
8/16	" " " "
8/23	Arb 3235 5" @ 3238 1000 acid Pump 240 Pot. TD 3259. Grav. 42.

COMPLETED

FORM 56 200 BKS. 1-44 PETROL

KANSAS

Pool Name Bloomer

Map No. 55 Sec. 12 Twp. 17 R. 10W


Well No. 2 Ploog

Bay Pet. Company

FIRST REPORT Contractor

C W L SE SE

SECTION PLAT

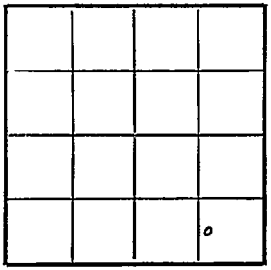

Ft. from N. Line

660 Ft. from S. Line

990 Ft. from E. Line

Ft. from W. Line

Ellsworth County

Location

Rig up

Drilling and Remarks:

Rotary

RECORD

Cased in., ft.

Sand

Gas

Oil

Total Depth

PRODUCTION

1st 24 hrs. Nat.

1st 24 hrs. after shot

Gas Cu. Ft.


Dry Hole

Abandoned

Date

JUL 12 1944 19

S. J. LEWIS Scout

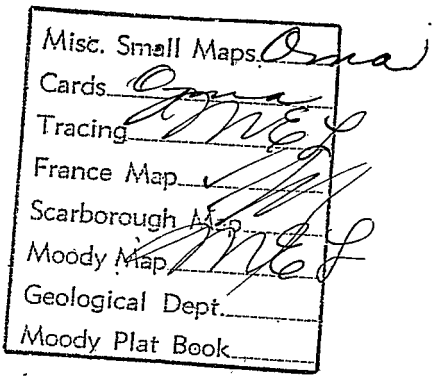
Misc. Small Maps
Cards
Tracing
France Map
Scarborough Map
Moody Map
Geological Dept.
Moody Plat Book

FORM 26 200 BKS. 2-44 PETROL

Pool Name Bloomer

Map No. 55 Sec. 12 Twp. 17 R. 10W


Well No. 2 Ploog

Bay Pet. Company

COMPLETED Contractor

C W L SE SE

SECTION PLAT

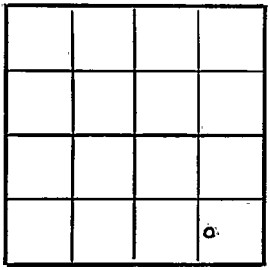

Ft. from N. Line

660 Ft. from S. Line

990 Ft. from E. Line

Ft. from W. Line

Ellsworth County

Location

Rig up

Drilling and Remarks:

Rec 3235'
5" @ 3238'
1000 Gals C
Pump 240 BF

4½ Hr

RECORD

Cased in., ft.

Sand

Gas

Oil

Total Depth 3259

PRODUCTION

1st 24 hrs. Nat.

1st 24 hrs. after shot

Gas Cu. Ft.


Dry Hole

Abandoned

Date

AUG 23 1944 19

S. J. LEWIS Scout

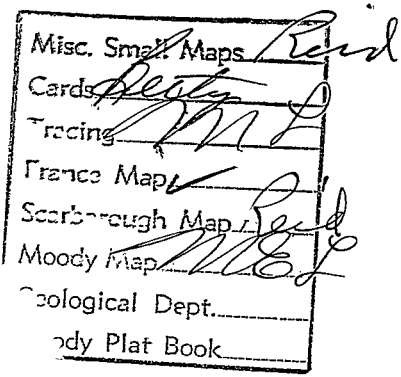
Misc. Small Maps
Cards
Tracing
France Map
Scarborough Map
Moody Map
Geological Dept.
Moody Plat Book