
FORM 51 25M 3-49 PETROL KANSAS Ellsworth

Section 12 Township 17 Range 10-W

Well No. #2 Plogg

Company Mallard Drlg.

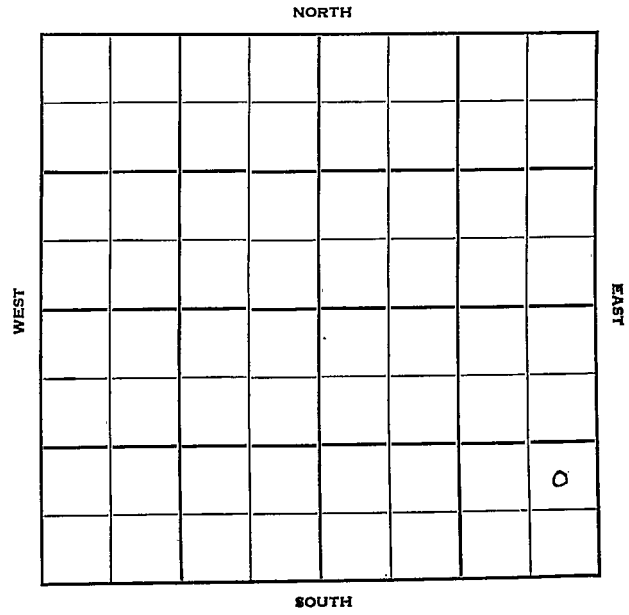

FORM 252-B
10M 9-49 PETROL

KANSAS Ellsworth

Sec. 12 Twp. 17 R. 10-W

Well No. #2 Plogg Farm

Mallard Drlg. Company

Contractor


Ft. from N. Line

990 Ft. from S. Line

330 Ft. from E. Line

Ft. from W. Line

NE SE SE

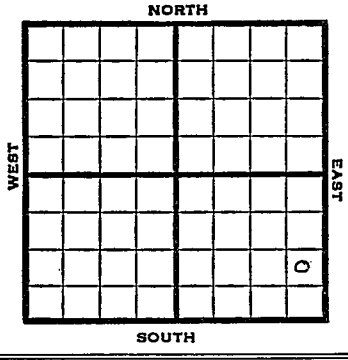

1950	Elev 1792	REPORT
7/5	8" @ 190 Arb 3247-51 5" @ 3247 TD 3252 750 acid 1500 acid Comp 50 bopd Completed **FIRST REPORT** **COMPLETED**	

Form 26 200 Bks. 11-49 Petrol

Kansas

Map No. _____ Sec. 12 Twp. 17 R. 10W

Well No. 2 Ploog


Mallard Drlg. Company

Contractor

El. 1792

NE SE SE

SECTION PLAT

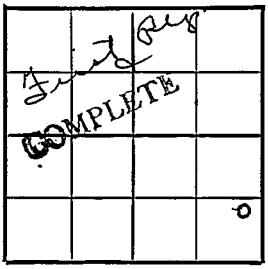

_____ Ft. from N. Line

990 Ft. from S. Line

330 Ft. from E. Line

_____ Ft. from W. Line

Ellsworth County

Location _____

Rig up _____

Drilling and Remarks:

8" @ 190

Arb. 3247-51

5" @ 3247

TD 3252

750 acid

1500 acid

RECORD

Cased _____ in., _____ ft.

Sand _____

Gas _____

Oil _____

Total Depth 3252

PRODUCTION

1st 24 hrs. Nat. _____

1st 24 hrs. after shot _____

Gas _____ Cu. Ft.


Dry Hole _____

Abandoned _____

Comp. 50 bopd

Date

JUL 5 1950 19 J E TYDA Scout

 

Scout Cards 7-W
Land Small Map
Land Wall Map
Tracings
France Map
Pierce Map
Misc.

JUL 11 1950

FORM 275 FOR SALE BY KANSAS BLUE PRINT CO


County Ellsworth State Kansas

Sec. 12 (Blk. Twp.) 17 (Sur. Rge.) 10W Map No.

Operator Mallard Drlg.

Well No. 2 Farm Ploog

Elev. 1792 Location NE SE SE

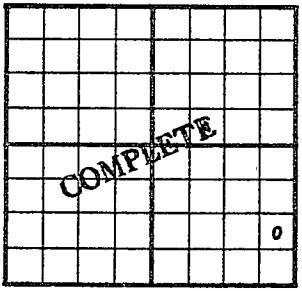

990 Ft. From S Line SE

330 Ft. From E Line Quarter

1st. Report 6-28-50

Completion 7-5-50

Remarks

Spudding Date 6-9-50

Drlg. Data Oil well TD 3252

8" @ 190 Arb. 3247-51 5" @ 3247

TD 3252 2250 A Comp. 50 bopd

Duplicate

J. E. TYRA

Scout Cards	mm
Land Small Map	
Land Wall Map	
Tracings	
France Map	
Pierce Map	
Misc.	

FEB 18 1952

Drlg. Data

Form 26 200 Bks. 11-49 Petrol Kansas

Map No. _____ Sec. 12 Twp. 17 R. 10W

Well No. 2 Ploog

Mallard Drlg. Company

Contractor

NE SE SE

SECTION PLAT



_____ Ft. from N. Line

990 Ft. from S. Line

330 Ft. from E. Line

_____ Ft. from W. Line

Ellsworth County

Location

Rig up

Drilling and Remarks:

Spud 6-9-50

8" C 190

Arb. 3247-51 TD

5" C 3247

P O P

RECORD

Cased _____ in., _____ ft.

Sand

Gas

Oil

Total Depth

PRODUCTION

1st 24 hrs. Nat.

1st 24 hrs. after shot

Gas _____ Cu. Ft.

Dry Hole

Abandoned

Date

JUN 2 8 1950 19

J. E. TYRA Scout

JUN 29 1955
Scout Cards
Land Small Map
Land Wall Map