


NO-RECORD

O.W.W.O. KANSAS
Ellsworth

Section 12 Township 17 Range 9W

Well No. #1 Nienke

Company Petroleum, Inc. (Was Cont'l Oil)

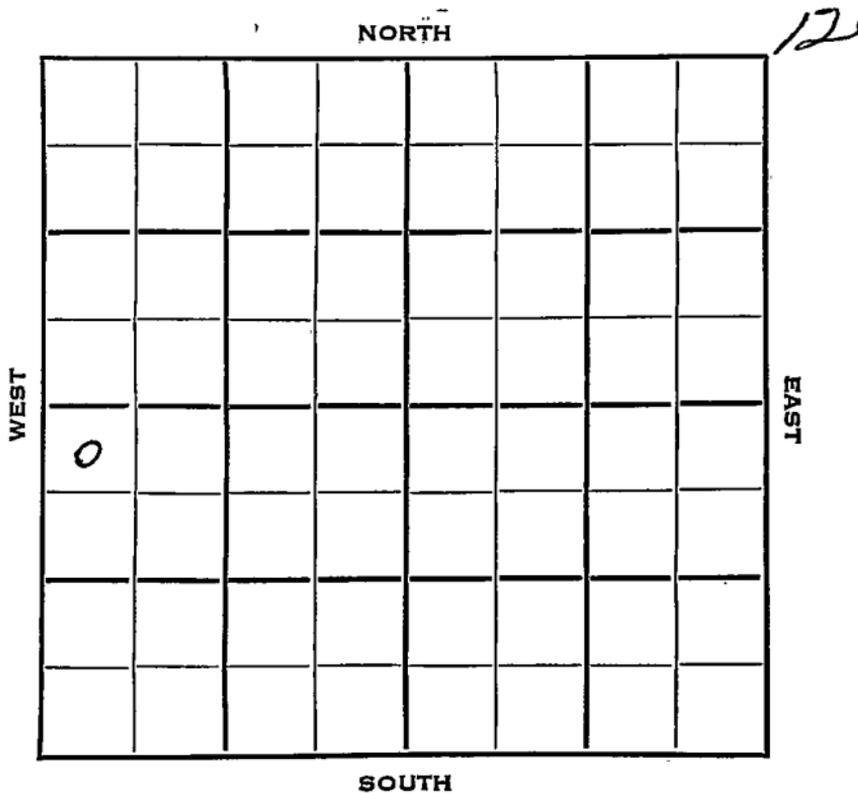

FORM 252-E
O.W.W.O.
NO-RECORD

Ellsworth KANSAS ✓

Sec. 12 Twp. 17 R. 9 W

Well No. # 1 Nienke Farm

Petroleum Inc. Company

Garvey Contractor


330 Ft. from N. Line

_____ Ft. from S. Line

_____ Ft. from E. Line

330 Ft. from W. Line

NW NW SW

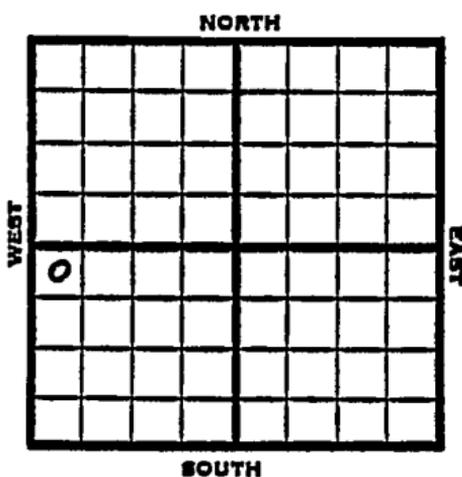

1953

O.W.W.O. NO REPORT
NO RECORD


9/2

Oil well TD 3270' Heeb 2725
Lans 2844 KC 2862 Cong 3195
Simp. 3199' Arb. 3245'
TD 3270' 4½" @ 3175 24/3054-60
12 GO 16 hr. 3500 A S/2 BOPH
Comp. 35 BOPD

FIRST REPORT

COMPLETED

County Ellsworth State Kansas
 Sec. 12 (Blk. 17) (Sur. 9W) (Twp. 17) (Rge. 9W) Map No. _____
 Operator Petroleum Inc. (was Cont'l Oil)
 Well No. 1 Farm Wienke
 Elev. _____ Location NE 1/4 SW

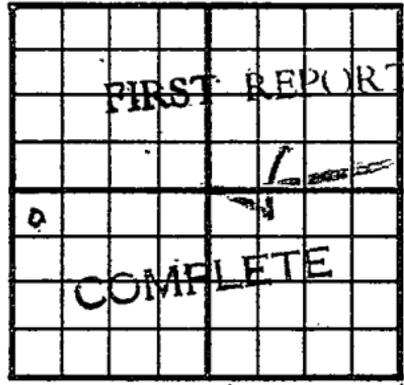

330 Ft. From N Line SW
330 Ft. From W Line Quarter
 Ist. Report SEP 2 1953
 Completion SEP 2 1953
 Remarks O.W.W.O.
Garvey - Contr.
 Spudding Date _____

Drilg. Data Oil well TD 3270
Hseb. 2725 Ians. 2844 KC 2862
Long. 3195 Simp. 3199 Arb. 3245
TD 3270 4 1/2" @ 3175 24/ 3054-60
12 go 16 hr. 3500 A S/ 2 boph
Comp. 35 bopd

NO-RECORD
W. P. ...