


Ellsworth

Map No. KANSAS Sec. 13 Twp. 17 R. 9W

Well No. 3- Janssen Farm
Vickers Pit Company

990 Ft. from N. Line
Ft. from S. Line
Ft. from E. Line
330 Ft. from W. Line
Elev. 1798

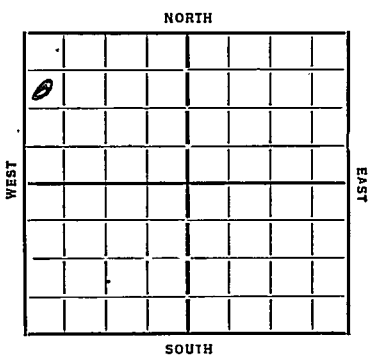

Date	REPORT	O. W. P. B.
1935		
6/5	Location	
6/13	Rig	
6/20		
6/28	dlg 880	
7/3	" 2375	
7/11	7" 3193 15 @ 2887 Prod	
7/17	hit 3211 T 7 3216	
	2127 bbls	

COMPLETED

1939	OVERB.	O. W. P. B.
3/1	Old T. D. 3216'	
	Arb. 3211'	
	Old potential 2127 bbls.	
	P. B. to 3145' in Lans.	
	Perf. 100 shots 3030-3050'	
	Pay 3037-40'	
	2700 acid.	
	Potential 15 bbls.	

FIRST REPORT
and COMPLETED

Ephraim

Map No. *45* Sec. *13* Twp. *17* R. *9W*

Well No. *3 - Ganssen*

Vickers Company Contractor

FIRST REPORTS

SECTION PLAT

990 Ft. from N. Line
..... Ft. from S. Line
..... Ft. from E. Line
330 Ft. from W. Line

<i>0</i>			

Location
Rig up
Drilling and Remarks:

RECORD

Cased ~~in.~~ in., ft.
Sand:
Gas
Oil
Total Depth:

PRODUCTION

1st 24 hrs. Nat.
1st 24 hrs. after shot.
Gas Cu. Ft.
Dry Hole
Abandoned

Date *6-5-35* 192.....

ORIGINAL MANUSCRIPT

Scout

Edwards

KANSAS

Form 26-1M Bks. 9-28
Map No. 43 Sec. 13 Twp. 17 R. 9W

Well No. 3 - Janssen

Vickers pet. Company

Contractor

2127 hbb

SECTION PLAT

990 Ft. from N. Line

Ft. from S. Line

Ft. from E. Line

330 Ft. from W. Line

0			

Location

Rig up

Drilling and Remarks:

2127 hbb

RECORD

Cased in. ft.

Sand bit 3211

Gas

Oil

Total Depth 3216

PRODUCTION

1st 24 hrs. Nat.

1st 24 hrs. after shot

Gas Cu. Ft.

Dry Hole

Abandoned

Date

7-17-35 192

2127 hbb

Scout

Ellsworth

Map No. 45 Sec. 13 Twp. 17 R. 9WWell No. 3 Janssen

Vickers

Company

FIRST REPORT

Contractor

COMPLETED

SW NW NW

990 Ft. from N. Line

_____ Ft. from S. Line

_____ Ft. from E. Line

330 Ft. from W. Line

SECTION PLAT

0			

LORRAINE POOL

Location _____

Rig up _____

Drilling and Remarks:

OWPB-OTD 3216

Arb. 3211

Old Poten. 2127

PB. 3145 in Lans.

Perf. 100 shots

3030-3050

Pay 3037-40

2700 Acid. Pot. 15

RECORD

Cased _____ in., _____ ft.

Sand _____

Gas _____

Oil _____

Total Depth _____

PRODUCTION

1st 24 hrs. Nat. _____

1st 24 hrs. after shot _____

Gas _____ Cu. Ft.

Dry Hole _____

Abandoned _____

Date

MAR 1 - 1939 19

H. D. Hatfield

Scout