


Ellsworth

Form 51-5M-5-34-Palace

Map No. KANSA Sec. 13 Twp. 17 R. 9W

Well No. 1 Nienke Farm
Bradley & Scoulon Company

NORTH

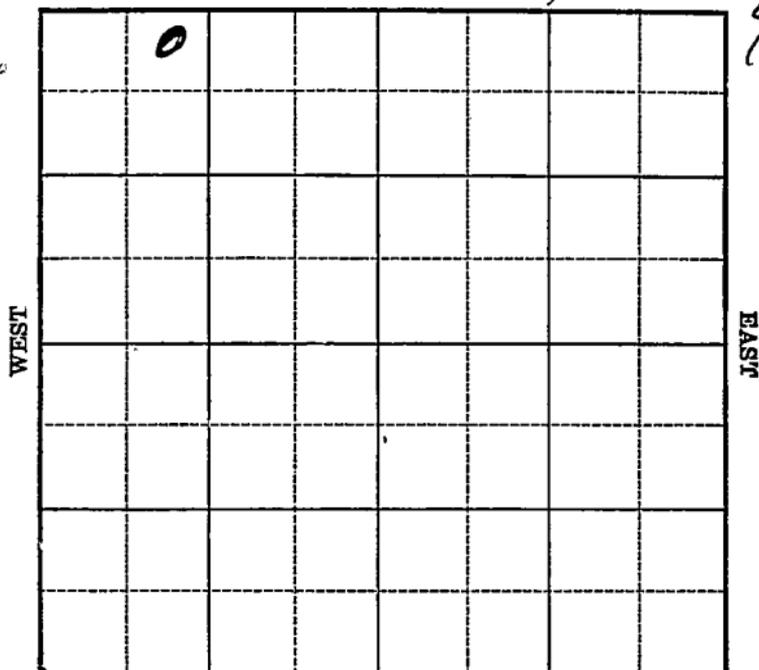

SOUTH

O. W. D. D

Location _____

Drilling Remarks _____

Rig Up _____

Drilling Remarks _____

RECORD

Cased _____ in. _____ ft.

Sand _____

Gas _____

Oil _____

Total Depth _____

PRODUCTION

1st 24 hrs. Nat. _____

1st 24 hrs. after shot _____

Gas _____ cu. ft.

Dry Hole _____

Abandoned _____

Ellsworth

Map No. KANGAS Sec. 13 Twp. 17 R. 9^W


Well No. 1 Nienke Farm
Bradley & Aculon Company

264 Ft. from N. Line

_____ Ft. from S. Line

_____ Ft. from E. Line

990 Ft. from W. Line

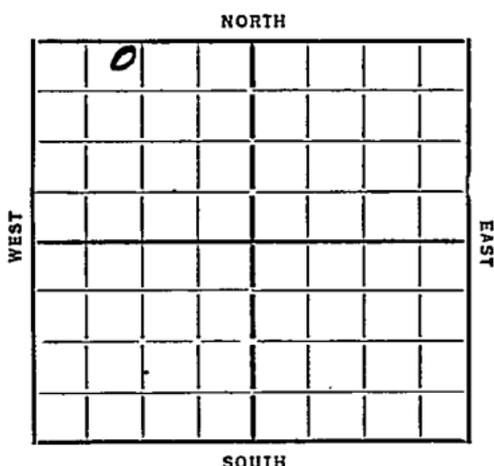

Date	REPORT	O. W. D. D
12/19	Cellar	
12/27	— 1/3/35 —	
1/10	Rig	
1/17	Rign	
1/24	SD 220	
1/31	SD 350	
2/7	Dlg 575	15" 336.
2/14	" 1480	12" 455
2/21	SD 1900	
2/28	Dlg. 2200	
3/7	— 3/14 —	
3/21	8" 2184	
3/27	T 7 2206	3 M Acc.

COMPLETED

O. W. D. D

1936
12/9 Old T. D. 2206'. H.F.W. 2966-70'.
Show oil 3042-47'. 5" @ 2988'.
T. D. 3051'. 4000 acid.
Pot. 236

FIRST REPORTS

and

COMPLETED

Edenwith
Map No. *45* Sec. *13* Twp. *17* R. *9W*

Well No. *1-Nienke*
Bradley & Scanlon Company

Contractor

COMPLETED

SECTION PLAT

0			

264 Ft. from N. Line
..... Ft. from S. Line
..... Ft. from E. Line
990 Ft. from W. Line

Location.....
Rig up.....
Drilling and Remarks:

3 m gas

RECORD

Cased.....in.,ft.
Sand.....
Gas.....
Oil.....
Total Depth *2206*

PRODUCTION

1st 24 hrs. Nat.....
1st 24 hrs. after shot.....
Gas.....Cu. Ft.
Dry Hole.....
Abandoned.....

Date

3-27-35 192

ORVAL MANSCHRECK
Scout

[Faint, illegible handwritten notes and scribbles, possibly including a large looped flourish.]

[A rectangular box containing handwritten text and a large 'X' mark. The text is mostly illegible but appears to be a list or set of instructions.]

[Faint, illegible handwritten notes and scribbles on the right side of the page.]

Map No. 45 Sec. 13 Twp. 17 R. 9W

Well No. 1 Niemke

Bradley & Co Company

Contractor

O. W. D. D

264 Ft. from N. Line

_____ Ft. from S. Line

_____ Ft. from E. Line

990 Ft. from W. Line

**FIRST REPORT
COMPLETED**

O.W.D.D.

SECTION PLAT

0			

Location _____

Rig up _____

Drilling and Remarks:

*Old TD 2206
NW 2966-70
Spur 13042-47
5102988
4000 acid
P 236*

RECORD

Cased _____ in., _____ ft.

Sand _____

Gas _____

Oil _____

Total Depth: 3051

PRODUCTION

1st 24 hrs. Nat. _____

1st 24 hrs. after shot _____

Gas _____ Cu. Ft.

Dry Hole _____

Abandoned _____

Date

DEC 9 1936

S. J. LEWIS Scout

Returned

Cards *Paul*

Tracing *JM*

France Map *BS*

Scarborough M. p. *BS*

Moody Map *BS*

Scarborough Plat Book *BS*

Moody Plat Book *BS*

Map No. 45 Sec. 13 Twp. 17 R. 9W

Well No. 1 - Nienke

Bradley & Scanlon Company

Contractor

FIRST REPORTS


SECTION PLAT

264 Ft. from N. Line

..... Ft. from S. Line

..... Ft. from E. Line

990 Ft. from W. Line

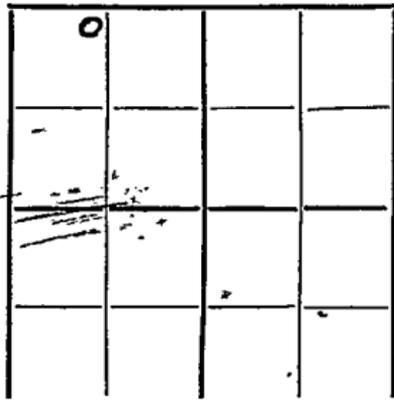

Location.....

Rig up.....

Drilling and Remarks:

clean

RECORD

Cased..... in., ft.

Sand.....

Gas.....

Oil.....

Total Depth.....

PRODUCTION

1st 24 hrs. Nat.....

1st 24 hrs. after shot.....

Gas..... Cu. Ft.

Dry Hole.....

Abandoned.....

Date

ORVAL MANNSCHRECK

12-19-34 192.....

Scout

no more

[Handwritten scribbles and lines]

Returned	<i>RAH</i>
Cards	<i>RAH</i>
Tickets	<i>MUS</i>
Francis Map	<i>[scribble]</i>
So.	<i>[scribble]</i>
I	<i>[scribble]</i>
Stat.	<i>[scribble]</i>
Map of	<i>[scribble]</i>