

Map No. **KANSAS** Sec. **13**Twp. **17**R. **9W**Well No. **#1 Janssen**


Farm

Vickers Pt.

Company

NORTH

WEST

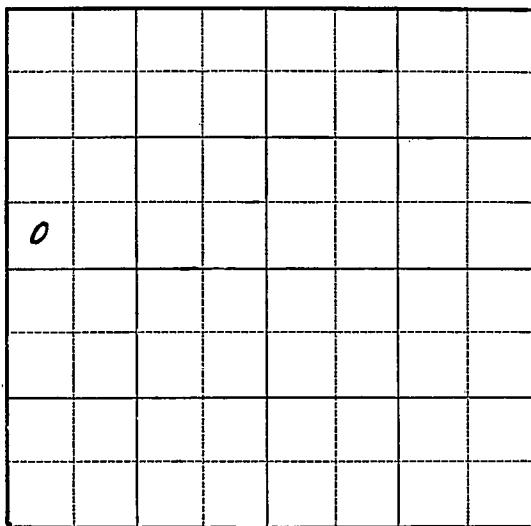

EAST

SOUTH

Location _____

Drilling Remarks _____

Rig Up _____

Drilling Remarks _____

RECORD

Cased _____ in. _____ ft.

Sand _____

Gas _____

Oil _____

Total Depth _____

PRODUCTION

1st 24 hrs. Nat. _____

1st 24 hrs. after shot _____

Gas _____ cu. ft.

Dry Hole _____

Abandoned _____

Ellsworth

Map No. KANSAS Sec. 13 Twp. 17 R. 9W


Well No. 1 Janssen Farm
Vickers Pst. Company

 Ft. from N. Line

330 Ft. from S. Line

 Ft. from E. Line

330 Ft. from W. Line

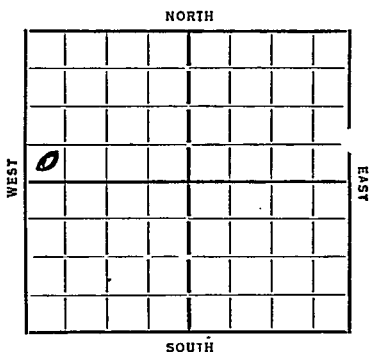

Date

REPORT

1935	Location
2/6	
2/14	Rig
2/21	Rgn
2/28	Ally 570 10" 210
3/7	" 2125
3/14	7" 3187
3/21	Rust
3/28	Sil. 3198 T7 3203 H.F.O.
4/3	Silicious 3198 T7 3203
	1747 Blk.

COMPLETED

Map No. 45 Sec. 13 Twp. 17 R. 9WWell No. 1- JanssenVickers Company


Contractor

FIRST REPORTS SECTION PLAT

Ft. from N. Line

330 Ft. from S. Line

Ft. from E. Line

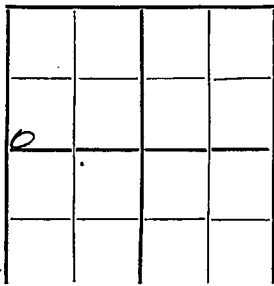330 Ft. from W. LineLocation ☒

Rig up

Drilling and Remarks:

RECORD

Cased _____ in., _____ ft.

Sand _____

Gas _____

Oil _____

Total Depth _____

PRODUCTION

1st 24 hrs. Nat. _____

1st 24 hrs. after shot _____

Gas _____ Cu. Ft.

Dry Hole _____

Abandoned _____

Date

J. VAL MANNSCHECK

2-6-35 192 _____ Scout

Form 26-1M Rev. 9-73
Ellsworth

MANSA

Map No. 45 Sec. 13 Twp. 17 R. 9W

Well No. 1- Janssen

Vickers pet Company

Contractor

COMPLETED

SECTION PLAT

Ft. from N. Line

330 Ft. from S. Line

Ft. from E. Line

330 Ft. from W. Line

0			

Location

Rig up

Drilling and Remarks:

1747 Hb

RECORD

Cased in., ft.

Sand Silurns 3198

Gas

Oil

Total Depth 3203

PRODUCTION

1st 24 hrs. Nat.

1st 24 hrs. after shot

Gas Cu. Ft.

Dry Hole

Abandoned

Date

ORVAL MANNSCHRECK

4-3-35 192 Scout