

Ellsworth

Map No. **KANSAS** Sec. 13 Twp. 17 R. 9^W


Well No. 2 - Janssen Farm
Vickers Pet. Company

_____ Ft. from N. Line

990 Ft. from S. Line

_____ Ft. from E. Line

330 Ft. from W. Line

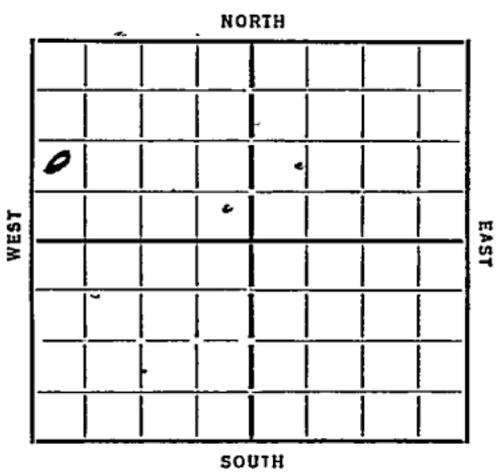

Date 1935

REPORT **O. W. P. B.**

4/17 Rig
4/26 10" 210
5/2 Alg 1910
5/9 3050 T7 PB 2300
5/16 — 5/23 — 5/29 — 6/6 — 6/13 —
6/20 6" 3185
6/28 Oil 3210-14 3000 oil
testing
7/2 Silicious 3210
 T7 3214
 2077 Bbls

COMPLETED

OVER

1939
3/1

O. W. P. B.

Old T. D. 3214'
Old potential 2077 bbls.
Arb. 3210'
P. B. to 3157' in Lans.
Perf. 50 shots 3030-3050'
Pay 3035-3040'
4000 acid.
Potential 16 bbls.

FIRST REPORT

and

COMPLETED

Map No. 45 Sec. 13 Twp. 17 R. 9WWell No. 2 - FinssenVickerspet Company

Contractor

FIRST REPORTS**SECTION PLAT**

Ft. from N. Line

990 Ft. from S. Line

Ft. from E. Line :

330 Ft. from W. Line

o			

Location.....

Rig up.....

Drilling and Remarks:

Rig**RECORD**

Cased..... in., ft.

Sand.....

Gas.....

Oil.....

Total Depth.....

PRODUCTION

1st 24 hrs. Nat.....

1st 24 hrs. after shot.....

Gas..... Cu. Ft.

Dry Hole.....

Abandoned.....

Date

4-17-35 192..... **ORVAL MANSCHIECK** Scout

Handwritten scribbles and lines at the top of the page.

Returned	<i>MS</i>
Cards	<i>MS</i>
Tracing	<i>MS</i>
France Map	MS
Scarborough Map	MS
Moody Map	MS
Scarborough Plat Book	MS
Moody Plat Book	MS

Handwritten scribbles at the bottom right of the page.

Edworth
Map No. *45* Sec. *13* Twp. *17* R. *9W*

Well No. *2-Janssen*
Vickers pet Company

Contractor

COMPLETED

SECTION PLAT

0			
T			

..... Ft. from N. Line

990 Ft. from S. Line

..... Ft. from E. Line

330 Ft. from W. Line

Location.....

Rig up.....

Drilling and Remarks:

2077 lbs

RECORD

Cased..... in., ft.

Sand *Janssen 3210*

Gas.....

Oil.....

Total Depth *3214*

PRODUCTION

1st 24 hrs. Nat.....

1st 24 hrs. after shot.....

Gas..... Cu. Ft.

Dry Hole.....

Abandoned.....

Date

7-2-35 192.....

ORVAL MANNSCHECK

Scout

no work

Returned	<i>✓</i>
Cards	<i>✓</i>
Tracing	<i>✓</i>
France Map	<i>✓</i>
Scarborough Map	<i>X</i>
Moody Map	<i>✓</i>
Scarborough Plat Book	<i>X</i>
Moody Plat Book	<i>X</i>

Ellsworth

Map No. 45 Sec. 13 Twp. 17 R. 9WWell No. 2 Janssen

Vickers

Company

FIRST REPORT

Contractor

COMPLETED

NW SW NW

Ft. from N. Line

990 Ft. from S. Line

Ft. from E. Line

330 Ft. from W. Line

LORRAINE POOL

SECTION PLAT

0			

Location _____

Rig up _____

Drilling and Remarks:

OWPB-OTD 3214

Old.Poten 2077

Arb. 3210

PB 3157 in Lans

Perf. 50 shots

3030-3050

Pay 3035-3040

4000 acid.Pot. 16

RECORD

Cased _____ in., _____ ft.

Sand _____

Gas _____

Oil _____

Total Depth _____

PRODUCTION

1st 24 hrs. Nat. _____

1st 24 hrs. after shot _____

Gas _____ Cu. Ft.

Dry Hole _____

Abandoned _____

Date

MAR 1 - 1939 19

H. D. Hatfield

Scout

Misc. Small Maps	<i>RAM</i>
Cards	<i>RAM</i>
Tracing	<i>gm</i>
France Map	<i>RAM</i>
Scarborough Map	<i>RAM</i>
Moody Map	
Geological Dist.	
Moody Map Book	