

Ellsworth

Map No. KANSAS Sec. 13 Twp. 17 R. 9W


Well No. 4 - Janssen Farm
Wickers Pet Company

_____ Ft. from N. Line

330 Ft. from S. Line

_____ Ft. from E. Line

990 Ft. from W. Line

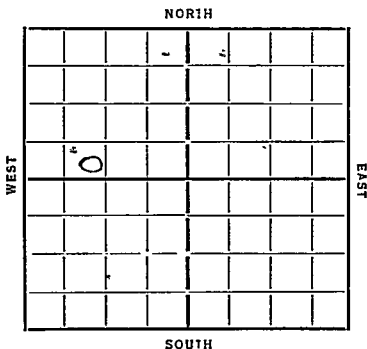

Date 1935

REPORT

O. W. F. B.

8/17 Spud
8/15 12 1/2 215
8/22 dly 1095
8/27 " 2585
8/29 " 2975
9/6 Nil 324 3219 7" 3198
9/12 Nil 3219
 T 7 32 1/2
 575 Oil
 400 Wtu.

COMPLETED


OVER

1939
3/1

O. W. P. B.

Old T. D. 3221 $\frac{1}{2}$ '
Old potential 575 bbls.
P. B. to 3123'
Perf. 60 shots 3030-65'
Pay 3055-60'
4000 acid.
Potential 18 bbls.

FIRST REPORT

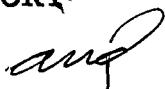

COMPLETED

Edlinworth
 Map No. 45 Sec. 13 Twp. 17 R. 9W
 Well No. 4 - Ganssen
Vickers Pet. Company
 Contractor

PLAT REPORT

SECTION PLAT

..... Ft. from N. Line
330 Ft. from S. Line
 Ft. from E. Line
990 Ft. from W. Line

0			

Location.....
 Rig up.....
 Drilling and Remarks:

Spud

RECORD

Cased..... in., ft.
 Sand.....
 Gas.....
 Oil.....
 Total Depth.....

PRODUCTION

1st 24 hrs. Nat.....
 1st 24 hrs. after shot.....
 Gas..... Cu. Ft.
 Dry Hole.....
 Abandoned.....

Date 8-7-35 192.....

ORVAL MANNSCHECK

Scout

Returned	
Cards	<i>[Handwritten mark]</i>
Tracing	<i>[Handwritten mark]</i>
France Map	X
Scarborough Map	X
Moody Map	X
Scarborough Plat Book	
Moody Plat Book	

no wall

KANSAS

Map No. 45 Sec. 13 Twp. 17 R. 9W

Well No. 4-Gunnen

Vickers Company

Contractor

COMPLETE

SECTION PLAT

0			

..... Ft. from N. Line

330 Ft. from S. Line

..... Ft. from E. Line

990 Ft. from W. Line

Location.....

Rig up.....

Drilling and Remarks:

575 oil
400 water

RECORD

Cased in. ft.

Sand Sil 3219

Gas.....

Oil.....

Total Depth 3221 1/2

PRODUCTION

1st 24 hrs. Nat.....

1st 24 hrs. after shot.....

Gas..... Cu. Ft.

Dry Hole.....

Abandoned.....

Date

9-12-35 192.....

ORVAL MANNSCHRECK

Scout

no trace

[Handwritten scribbles and lines]

Returned	<i>[initials]</i>
Cards	<i>[initials]</i>
Tracing	<i>[initials]</i>
France Map	<i>[initials]</i>
Scarborough Map	<i>[initials]</i>
Moody Map	<i>[initials]</i>
Scarborough Plat Book	
Moody Plat Book	

Ellsworth

Map No. 45 Sec. 13 Twp. 17 R. 9WWell No. 4 Janssen

Vickers

Company

FIRST REPORT

Contractor

COMPLETED

SE SW NW

 Ft. from N. Line330 Ft. from S. Line Ft. from E. Line990 Ft. from W. Line

LORRAINE POOL

SECTION PLAT

Location Rig up

Drilling and Remarks:

OWPB-OTD 3221 $\frac{1}{2}$

Old Poten. 575

PB 3123; Perf. 60 shots

3030-65

Pay 3055-60

4000 acid

Pot. 18

RECORD

Cased in., ft.Sand Gas Oil Total Depth

PRODUCTION

1st 24 hrs. Nat. 1st 24 hrs. after shot Gas Cu. Ft.Dry Hole Abandoned

Date

MAR 1 1939

H. D. Hatfield

Scout

Misc Small Maps	<i>Ray</i>
Cards	<i>Ray</i>
Tracing	<i>Ray</i>
France Map	<i>Ray</i>
Scarborough's Map	<i>Ray</i>
Moody Map	<i>Ray</i>
Ceological Dept.	
Moody Flat Book	