

Ellsworth

Form 51-5M-5-34-Palace

Map No. KANSAS Sec. 13 Twp. 17 R. 9W


Well No. 2 Rolfe Farm

Twin State

Company

NORTH

WEST

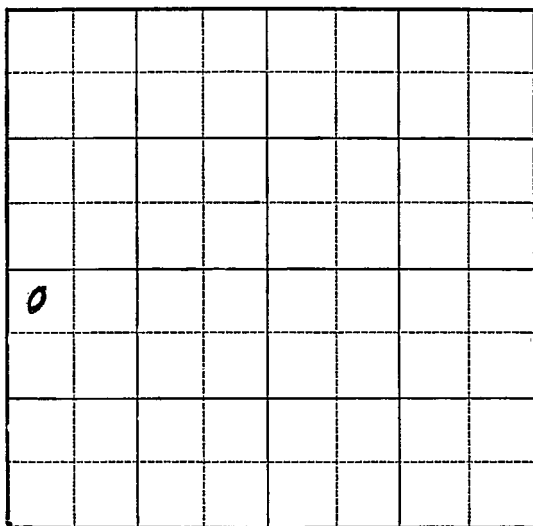

EAST

SOUTH

Location

Drilling Remarks

Rig Up

Drilling Remarks

RECORD

Cased in. ft.

Sand

Gas

Oil

Total Depth

PRODUCTION

1st 24 hrs. Nat.

1st 24 hrs. after shot

Gas cu. ft.

Dry Hole

Abandoned

Ellsworth

Map No. KANSAS Sec. 13 Twp. 17 R. 9W


Well No. #2 Rolfe Farm
Twin State Company

330 Ft. from N. Line

_____ Ft. from S. Line

_____ Ft. from E. Line

330 Ft. from W. Line

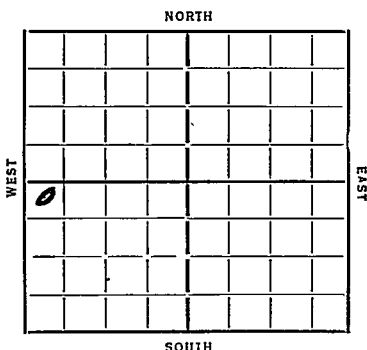

Date 7/25

REPORT E1.1791

1/16 Ring

1/24 Ring

1/31 Spud

2/7 15 1/2 291 13" 440

2/14 Alg 1680

2/21 " 2365 10" 1820

2/28 " 2875

3/7 " 3165 8" 2994

3/14 Siliceous 3199 Pcy 3201-03

3/20 Tubing

3/20 Siliceous 3199 Oil 3201-03

3/20 T 17 3203 1300 Blk

COMPLETED

Map No. 45 Sec. 13 Twp. 17 R. 9W

Well No. 2-Rolpo

Twin Heg Company

Contractor

FIRST REPORTS

SECTION PLAT

330 Ft. from N. Line

..... Ft. from S. Line

..... Ft. from E. Line

330 Ft. from W. Line

0			

Location.....

Rig up.....

Drilling and Remarks:

Rig

RECORD

Cased.....in., ...ft.

Sand.....

Gas.....

Oil.....

Total Depth.....

PRODUCTION

1st 24 hrs. Nat.....

1st 24 hrs. after shot.....

Gas.....Cu. Ft.

Dry Hole.....

Abandoned.....

Date

1-16-35 192.....

ORVAL MANNSCHRECK

Scout

Map No. 45 Sec. 13 Twp. 17 R. 9WWell No. 2- RaysTwin Hedges Company

Contractor

COMPLETED**SECTION PLAT**

0			

330 Ft. from N. Line

Ft. from S. Line

Ft. from E. Line

330 Ft. from W. Line

Location

Rig up

Drilling and Remarks:

1300 Hlo**RECORD**

Cased in., ft.

Sand siliceous 3199

Gas

Oil 3201-03Total Depth 3203**PRODUCTION**

1st 24 hrs. Nat.

1st 24 hrs. after shot

Gas Cu. Ft.

Dry Hole

Abandoned

Date

ORVAL MANN SCHRECK3-20-35 192 Scout