


Ellsworth

Form 51-5M-5-34-Palace

Map No. KANSAS Sec. 13 Twp. 17 R. 9 W

Well No. 1 Rolfs Farm
Super Co Company

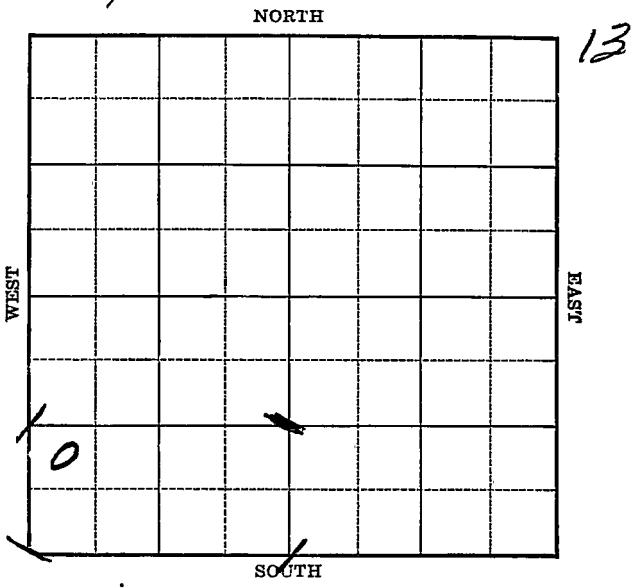

Location _____
Drilling Remarks _____

Rig Up _____
Drilling Remarks _____

RECORD

Cased _____ in. _____ ft.
Sand _____
Gas _____
Oil _____
Total Depth _____

PRODUCTION

1st 24 hrs. Nat. _____
1st 24 hrs. after shot _____
Gas _____ cu. ft. _____
Dry Hole _____
Abandoned _____

Ellsworth

Map No. KANSAS Sec. 13 Twp. 17 R. 9W


Well No. 1 Rolfe Farm
Tyler Co. Company

 Ft. from N. Line

990 Ft. from S. Line

 Ft. from E. Line

330 Ft. from W. Line

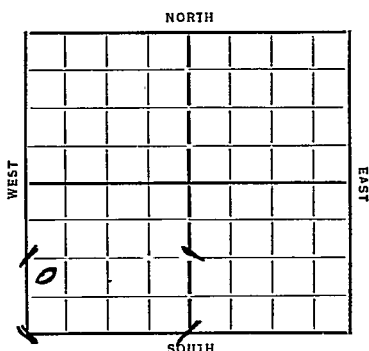

Date 1934

REPORT

E1.1788

11/27 Location
12/6 Rig
12/13
12/21 15 1/2 298
12/27 slg 960
1/3/35 " 1880
1/10 " 2320 10" 1802
1/17 " 2945
1/24 Lansing 2855 8" 2993
1/31 Simpson 3183 6" 3207
Silicious 3209 Pay 3210-12 1/2
HFO 2 hrs. Hook 465 oil 5 hrs.
Shs Water
7/6 Silicious 3209 TD 3212 1/2
1364 Bbls oil 140 Water.

COMPLETED

KANSA

Map No. 45 Sec. 13 Twp. 17 R. 9WWell No. 1-RolfsTexas Company Company

Contractor


FIRST REPORTS

SECTION PLAT

Ft. from N. Line

990 Ft. from S. Line

Ft. from E. Line

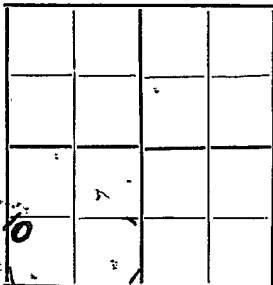330 Ft. from W. LineLocation ✓

Rig up

Drilling and Remarks:

RECORD

Cased in., ft.Sand Gas Oil Total Depth

PRODUCTION

1st 24 hrs. Nat. 1st 24 hrs. after shot Gas Cu. Ft.Dry Hole Abandoned

Date

11-27-34 192

ORVAL MANNSCHRECK

Scout

Map No. 45 Sec. 13 Twp. 17 R. 9WWell No. 1- RalphTexas company Company

Contractor

COMPLETED

SECTION PLAT

0			

Ft. from N. Line

990 Ft. from S. Line

Ft. from E. Line

330 Ft. from W. Line

Location

Rig up

Drilling and Remarks:

1364 bbls oil140 water

RECORD

Cased 3209 in., 3209 ft.Sand siliceousGas ✓Oil ✓Total Depth 3212 1/2

PRODUCTION

1st 24 hrs. Nat. ✓1st 24 hrs. after shot ✓Gas ✓ Cu. Ft.Dry Hole ✓Abandoned ✓

Date

2-6-35 192

ORVAL MANNSCHRECK

Scout