


Section 13 Township 17 Range 9W

Well No. #1 Souberli

Company Musgrove Pet.

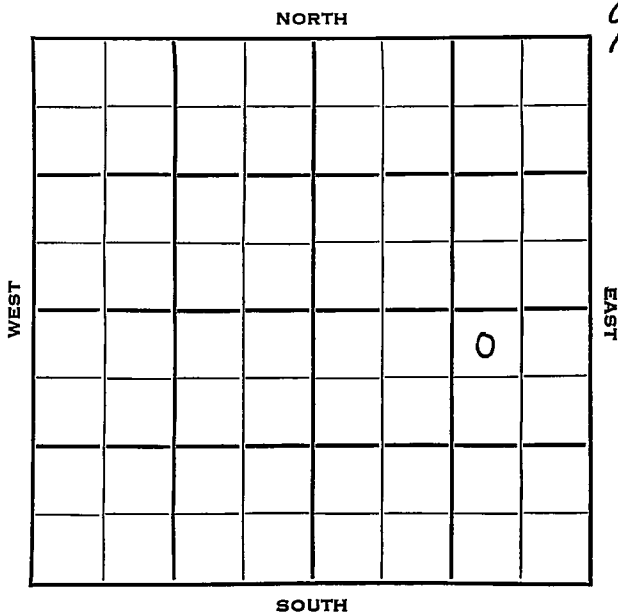

Ellsworth

KANSAS ✓

Sec. 13 Twp. 17 R. 9WWell No. #1 Souberli FarmMusgrove Pet.

Company

Musgrove

Contractor


330 Ft. from N. Line

Ft. from S. Line

990 Ft. from E. Line

Ft. from W. Line

NW NE SE

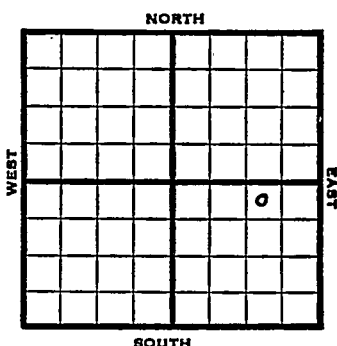

1953 Elev. 1792' REPORT

8/12 Spud 8-9-53
8" @ 307'
Drlg 380'

8/19 Heeb 2723, Tor 2740, Br Li 2839,
Lans 2859, Cong 3195
RTD 3266,
D&A

8/26 Spud 8-9-53 D & A TD 3266
8" @ 307 Heeb 2723 Tor. 2740
Br. lime 2839' Lans 2859'
Cong. 3195 Simp. 3209' Arb. 3257'
TD 3266 D & A

ABANDONED

County **Ellsworth** State **Kansas**

Sec. 13 (Blk. Twp.) 17 (Sur. Rge.) 9W Map No.

Operator Musgrove Pet.

Well No. **1** Farm **Souberli**

Elev.	Location	NW	NE	SE
-------	----------	----	----	----

FIRST REPORT

330 Ft. From N Line SE

990 Ft. From π Line Quarter

1st. Report AUG 12 1953

Completion

Remarks


Musgrove - Contr.

Spudding Date 8-9-53 .

Drig. Data

8" @ 307 drlg. 380

County Ellsworth State Kansas
 Sec. 13 (Blk. 17 (Sur. 9W Map No.)
 Operator Musgrove Pet.
 Well No. 1 Farm Souberli
 Elev. 1792 Location NW NE SE

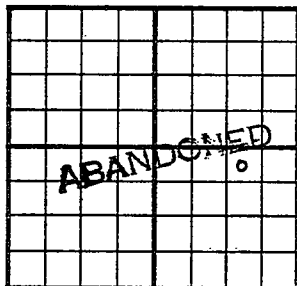

330 Ft. From N Line SE
990 Ft. From E Line Quarter

1st. Report

Completion AUG 26 1953

Remarks

Musgrove - Contr.

Spudding Date 8-9-53

Drilg. Data D & A TD 3266
8" @ 307 Heeb. 2723 Tor. 2740
Br. lime 2839 Lans. 2859 Cong. 3195
Simp. 3209 Arb. 3257 TD 3266
D & A

J. G. McGEHEE