


Section 13 Township 17 Range 10-W

Well No. #1 Stratmann

Company Elmer Ash.

NORTH Stratmann Pool

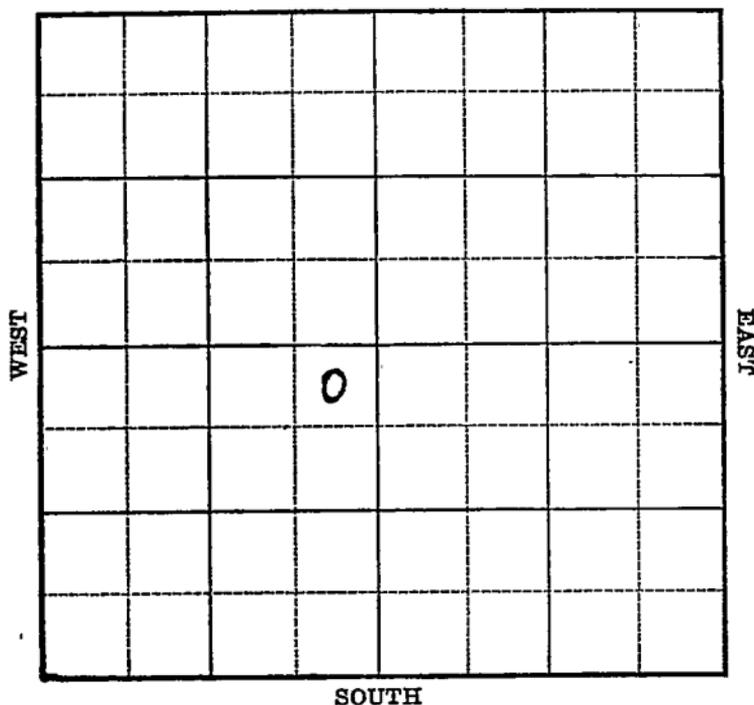

Sec. 13 Twp. 17 R. 10WWell No. #1 Stratmann FarmElmer Ash Company

(Stratmann Pool)


330 Ft. from N. Line

\_\_\_\_\_ Ft. from S. Line

330 Ft. from E. Line

\_\_\_\_\_ Ft. from W. Line

Elev. 1787

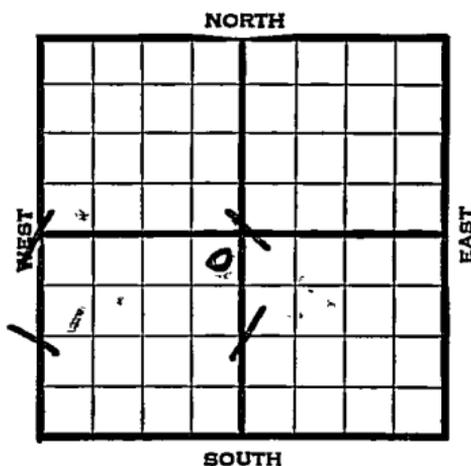

1939

## REPORT

6/7

Location

6/16

Cable Rig.

6/23

Rigging up.

6/29

Anhy 505' 12" - 527'

Drlg. 975'

7/6

Drlg. 1750'

7/13

10" - 1853' 8" - 2165'

T.D. 2195' U.R. 8".

7/20

8" - 2240' Estimated 2 M gas  
2515-25' T.D. U.R. 8".

7/27

8" - 2540' Drlg. 2725'

8/3

K. C. 2917' S.O. 3015-20'

7" - 3105' Drlg. 3165'

8/10

7" - 3210' Cong. 3235'

T.D. 3255' U.R. 7".

8/16

Arb. 3280' water.

T.D. 3302'

ABANDONED

**KANSAS**

**Ellsworth**

Map No. 55 Sec. 13 Twp. 17 R. 10W

Well No. 1 Stratmann

Elmer Ash Company

Contractor

**FIRST REPORT**

**NE SW**

330 Ft. from N. Line

\_\_\_\_\_ Ft. from S. Line

330 Ft. from E. Line

\_\_\_\_\_ Ft. from W. Line

**SECTION PLAT**


**STRATMANN POOL**

Location X

Rig up \_\_\_\_\_

Drilling and Remarks:

**RECORD**

Cased \_\_\_\_\_ in., \_\_\_\_\_ ft.

Sand \_\_\_\_\_

Gas \_\_\_\_\_

Oil \_\_\_\_\_

Total Depth \_\_\_\_\_

**PRODUCTION**

1st 24 hrs. Nat. \_\_\_\_\_

1st 24 hrs. after shot \_\_\_\_\_

Gas \_\_\_\_\_ Cu. Ft.

Dry Hole \_\_\_\_\_

Abandoned \_\_\_\_\_

Date

JUN 7 1939 19

S. J. LEWIS

Scout

Map No. 55 Sec. 13 Twp. 17 R. 10W

Well No. 1 Stratmann

Elmer Ash Company

Contractor

**ABANDONED**

NE SW


330 Ft. from N. Line

\_\_\_\_\_ Ft. from S. Line

330 Ft. from E. Line

\_\_\_\_\_ Ft. from W. Line

**SECTION PLAT**

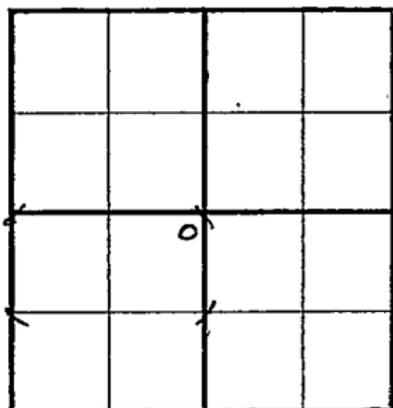

**STRATMANN POOL**

Location \_\_\_\_\_

Rig up \_\_\_\_\_

Drilling and Remarks:

*Cu & 3250*

*Water.*

**RECORD**

Cased \_\_\_\_\_ in., \_\_\_\_\_ ft.

Sand \_\_\_\_\_

Gas \_\_\_\_\_

Oil \_\_\_\_\_

Total Depth 3252

**PRODUCTION**

1st 24 hrs. Nat. \_\_\_\_\_

1st 24 hrs. after shot \_\_\_\_\_

Gas \_\_\_\_\_ Cu. Ft.

Dry Hole \_\_\_\_\_

Abandoned \_\_\_\_\_

Date

AUG 16 1939 19

S. J. LEWIS Scout