
KANSAS Ellsworth

FORM 51 5M PETROL

Section 13 Township 17 Range 10W

Well No. 1 ~~Ploog~~ Hilkins

Company Beardmore Drlg. etal

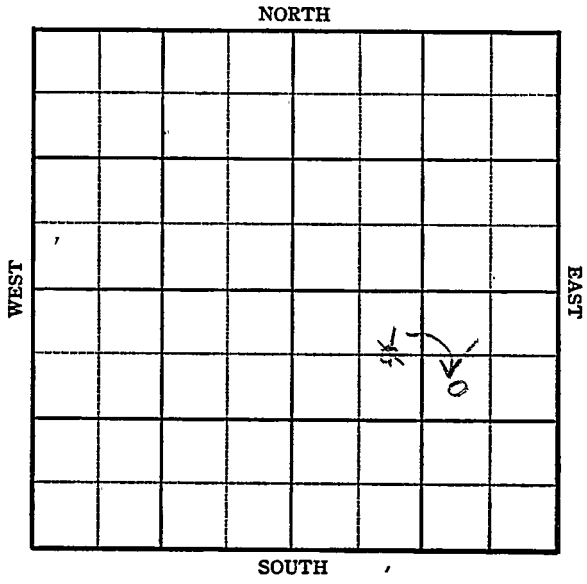

FORM 252-A
5M 8-45 PETROL

KANSAS Ellsworth

Sec. 13 Twp. 17 R. 10-W

Well No. #1 ~~Ploog~~ Wilkins Farm


Beardmore Drlg. etal Company

660 Ft. from N. Line

_____ Ft. from S. Line

_____ Ft. from E. Line

990 Ft. from W. Line

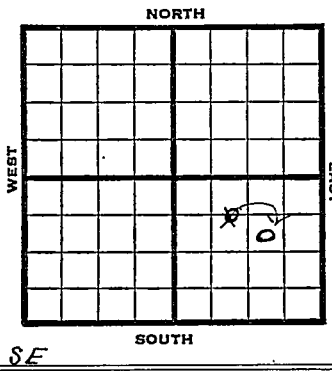

~~C E L NW SE~~ SW NE SE

REPORT

1945	Elev. 1782
11/7	Location
11/14	RUR
11/21	8" @ 240 Drlg. 2106'
11/28	Lans 2896 Cong 3232 Arb. 3238 TD 3243 5" @ 3243 RUST
12/5	" " "
12/12	Arb. 3238 5" @ 3243 TD 3270'

ABANDONED

FORM 56 200 BKS, 1-44 PETROL

KANSAS Kansas Pool Name Stoltenberg

Map No. 55 Sec. 13 Twp. 17 R. 10W

Well No. 1 Ploog

Beardmore Dlrg: etal Company

FIRST REPORT Contractor

C E L NW SE


660 Ft. from N. Line

Ft. from S. Line

Ft. from E. Line

990 Ft. from W. Line

SECTION PLAT

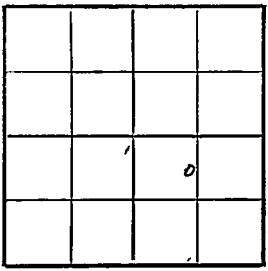

Ellsworth County

Location x

Rig up

Drilling and Remarks:

RECORD

Cased in., ft.

Sand

Gas

Oil

Total Depth

PRODUCTION

1st 24 hrs. Nat.

1st 24 hrs. after shot

Gas Cu. Ft.

Dry Hole

Abandoned

Date

NOV 7 1945

19 S. J. LEWIS Scout

FORM 26 200 BKS 1-44 PETROL

KANSAS Kansas

Pool Name Stoltenberg

Map No. 55 Sec. 13 Twp. 17 R. 10W


Well No. 1 Wilkins

Beardmore Drlg. etal Company

CORRECTION Contractor

C E L NW SE

SECTION PLAT

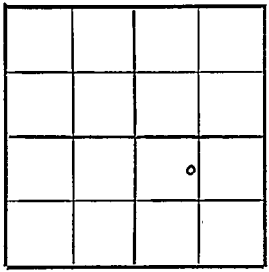

666 Ft. from N. Line

Ft. from S. Line

990 Ft. from E. Line

Ft. from W. Line

Ellsworth County

Location

Rig up

Drilling and Remarks:

reported in
#1 Ploog

RECORD

Cased in., ft.

Sand

Gas

Oil

Total Depth

PRODUCTION

1st 24 hrs. Nat.

1st 24 hrs. after shot

Gas Cu. Ft.

Dry Hole

Abandoned

Date

NOV 1 4 1945 19 S. J. LEWIS Scout

FORM 26 200 BKS 1-44 PETROL

Kansas Pool Name Steltenberg

Map No. 5-S Sec. 13 Twp. 17 R. 10W

Well No. 1 Wilkins

Beardmore Drlg. etal. Company

CORRECTION

Contractor

SW NE SE


990 Ft. from N. Line

Ft. from S. Line

990 Ft. from E. Line

Ft. from W. Line

SECTION PLAT

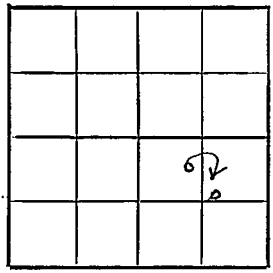

Ellsworth County

Location

Rig up

Drilling and Remarks:

Reported
C E L NW SE

RECORD

Cased in., ft.

Sand

Gas

Oil

Total Depth

PRODUCTION

1st 24 hrs. Nat.

1st 24 hrs. after shot

Gas Cu. Ft.

Dry Hole

Abandoned

Date

NOV 2 1 1945 19

S. J. LEWIS Scout

FORM 26 200 BKS 1-44 PETROL

KANSAS Kansas Pool Name Stoltenberg

Map No. K-5-5 Sec. 13 Twp. 17 R. 10W

Well No. 1 Wilkins


Beardmore Drlg. etal Company

ABANDONED Contractor

SW NE SE

E 1,1782

SECTION PLAT

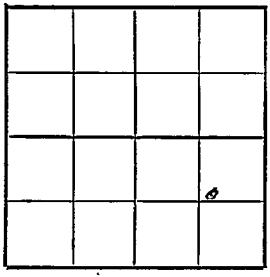

990 Ft. from N. Line

Ft. from S. Line

990 Ft. from E. Line

Ft. from W. Line

Ellsworth County

Location

Rig up

Drilling and Remarks:

Rec. Y3238

5" C0324S

RECORD

Cased in., ft.

Sand

Gas

Oil

Total Depth 2270

PRODUCTION

1st 24 hrs. Nat.

1st 24 hrs. after shot

Gas Cu. Ft.

Dry Hole

Abandoned

Date

DEC 12 1945

19 S. J. LEWIS Scout