


Section 13 Township 17 Range 10-W

Well No. 1 Wilkens


Company C. E. Ash et al

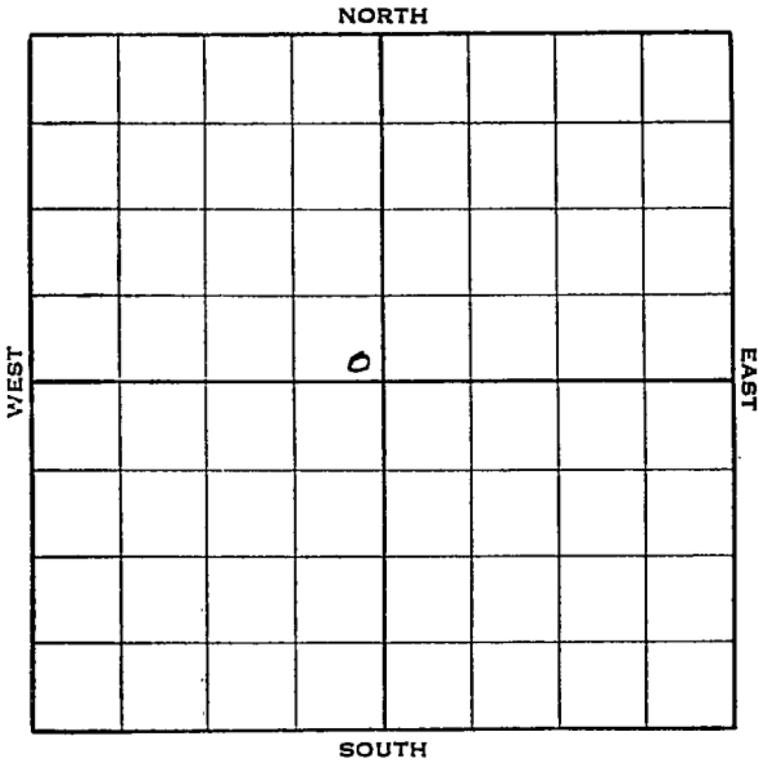

Sec. 13 Twp. 17 R. 10-W

Well No. #1 Wilkens Farm
C. E. Ash et al Company

_____ Ft. from N. Line
330 Ft. from S. Line
330 Ft. from E. Line
 _____ Ft. from W. Line

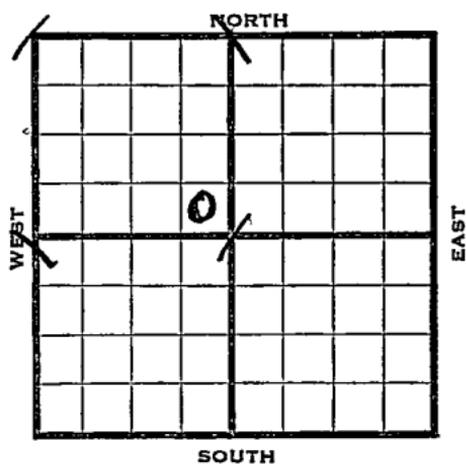

Elev. 1786

1938	REPORT
6/15	Location
6/24	"
7/1	"
7/8	C. R.
7/15	"
7/22	"
7/29	"
8/5	"
8/12	"
8/19	"
8/26	"
9/2	"
9/9	"
9/16	R. U.
9/23	"
9/30	15" - 205'.
	Drlg. 447'.
10/7	Anhy 520'.. 12" - 525'.
	Dlg. 1310'.
10/14	10" - 1855'. Dlg. 2020'.
10/21	T.D. 2175'. U. R. 10".

OVER

1938

10/28 10" - 2236'. Dlg. 2285'.

11/4 8" - 2548'. Dlg. 2825'.

11/12 Lans. 2924'. S. G. 2952'.
S. S. O. 3070'. 6" - 3127'.
Drlg. 3130'.

11/18 Cong. 3228'. Arb. 3254'.
5"-liner 3254'.
Pay 3279-82' T.D.
1100' oil 16 hrs.
Total 2500'. Gravity 45.

11/25 Swab 3 oil per hour.
1000 acid.

11/30 6" - 3127'.
5"-liner 3254'.
Arb. 3254'.
T. D. 3282'.
1000 acid.
Potential 381 bbls.
No water.

COMPLETED

Map No. 53 Sec. 13 Twp. 17 R. 10WWell No. 1 WilkensC. E. Ash et al Company

Contractor


FIRST REPORT
SE NW

_____ Ft. from N. Line

330 Ft. from S. Line330 Ft. from E. Line

_____ Ft. from W. Line

SECTION PLAT

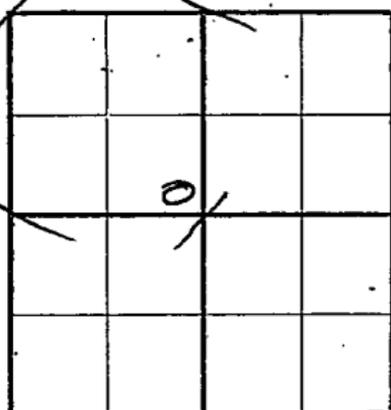Location X

Rig up _____

Drilling and Remarks:

RECORD

Cased _____ in., _____ ft.

Sand _____

Gas _____

Oil _____

Total Depth _____

PRODUCTION.

1st 24 hrs. Nat. _____

1st 24 hrs. after shot _____

Gas _____ Cu. Ft.

Dry Hole _____

Abandoned _____

Date

JUN 15 1938 19

H. D. Hatfield

Scout

[Handwritten scribbles]

Returned	<i>[Signature]</i>
Cards	<i>[Signature]</i>
Tracing	<i>[Signature]</i>
Trance Map	<i>[Signature]</i>
Scarborough Map	<i>[Signature]</i>
Body Map	<i>[Signature]</i>
Scarborough Flat Book	
Body Flat Book	

Misc Small Maps
Cards
Tracing
France Map
Scarborough
Moody Map
Geological Dept.
Moody Flat Book

RAY

RAY

RAY

RAY