


Map No. KANSAS Sec. 13 Twp. 17 R. 10^W

Well No. 1 Wilkens Farm

Smith & Ash et al Company

NORTH

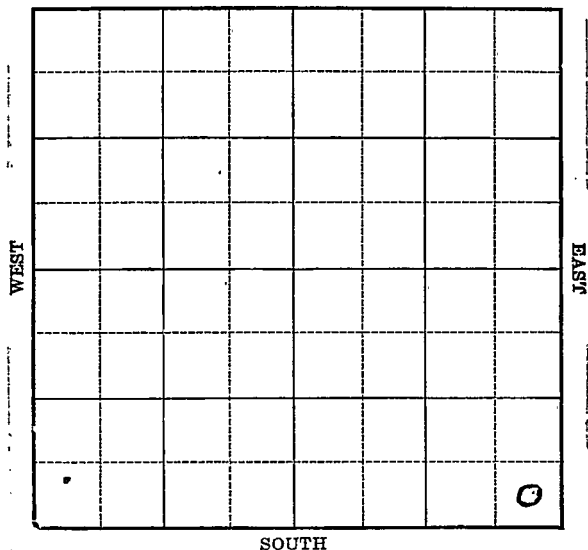

Drilling Remarks

Drilling Remarks

Cased _____ in. _____ ft.

Sand

Gas

Oil

Total Depth_____

1st 24 hrs. Nat.-----

1st 24 hrs. after shot-----

Gas _____ cu. ft. _____

Dry Hole

Abandoned


Ellsworth

Map No. KANSAS Sec. 13 Twp. 17 R. 10WWell No. 1 Wilkins Farm
Smith & Ash et al Company

_____ Ft. from N. Line

330 Ft. from S. Line330 Ft. from E. Line

_____ Ft. from W. Line

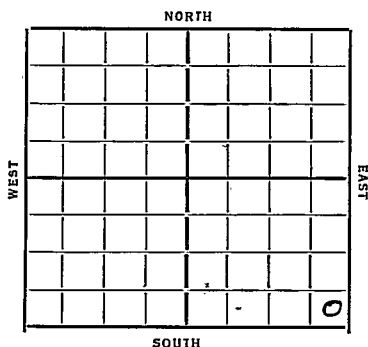Date 1934

REPORT

2/7 M.O. G.2/14 Bldg Rig2/23 Rigging Up.3/13/9 5D 853/15 dily 4003/22 " 9483/29 " 17854/5 " 2590 10" 9504/12 " 3060 K.C. Line 29054/19 Siliceous 3260 TD 32802700' oil 24 hrs. after head
swabbed off swab 7 BBL
per hr.4/26 1000 Gal acid 47 BBL 6 hrs
swab. some water5/35/9 Siliceous 3260 TD 32801000 gal acid 205 oil 30 water

COMPLETED

Edgewood
 Map No. *55* Sec. *13* Twp. *17* R. *10W*
 Well No. *1- Wilkens*
Smith & Ash et al Company
 Contractor

SECTION PLAT

FIRST REPORTS

_____ Ft. from N. Line
330 Ft. from S. Line
330 Ft. from E. Line
 _____ Ft. from W. Line

			0

Location _____
 Rig up _____
 Drilling and Remarks:

M.O.T.

RECORD

Cased _____ in., _____ ft.
 Sand _____
 Gas _____
 Oil _____
 Total Depth _____

PRODUCTION

1st 24 hrs. Nat. _____
 1st 24 hrs. after shot _____
 Gas _____ Cu. Ft.
 Dry Hole _____
 Abandoned _____

Date

2-7-34 192 *O. Manschuet* Scout

~~no wall out of~~

To - med	
RS	
CRK	
-1	X
X	X

Edwards
 Map No. 55 Sec. 13 Twp. 17 R. 10W
 Well No. 1- Wilkens

Smith + Ash Company

Contractor

COMPLETED

SECTION PLAT

			0

Ft. from N. Line

330 Ft. from S. Line

330 Ft. from E. Line

Ft. from W. Line

Location

Rig up

Drilling and Remarks:

1000 gal add

205 oil
30 water

RECORD

Cased _____ in., _____ ft.

Sand silicenus 3260

Gas

Oil

Total Depth 3280

PRODUCTION

1st 24 hrs. Nat.

1st 24 hrs. after shot

Gas _____ Cu. Fts.

Dry Hole

Abandoned

Date

5-9-34 19

ORVAL MANNSCHRECK

Scout

Returned *RDJ*
Cards *RDJ*
Tracing *RDJ*
France Map *X*
Scarborough Map *X*
Moody Map *X*
Scarborough Plat Book

Plat Book