

KANSAS


Ellsworth

FORM 51 5M BR1X

Section 13 Township 17 Range 10W

Well No. #2 Wilkens

Company Bay Pet.

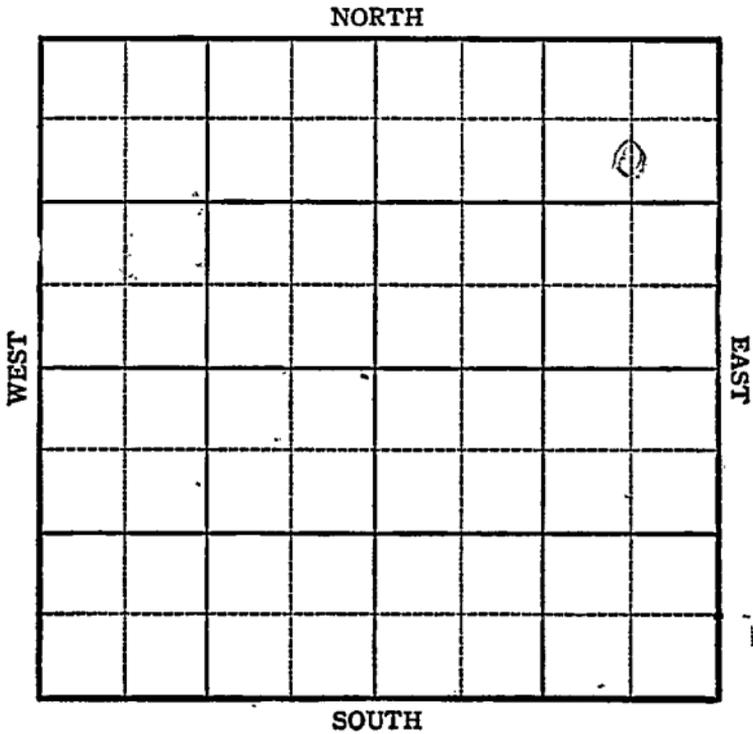

KANSAS

Sec. 13 Twp. 17 R. 10W

Well No. 2 Wilkens Farm


Bay Pet. Company
Stoltenberg

990 Ft. from N. Line

_____ Ft. from S. Line

660 Ft. from E. Line

_____ Ft. from W. Line

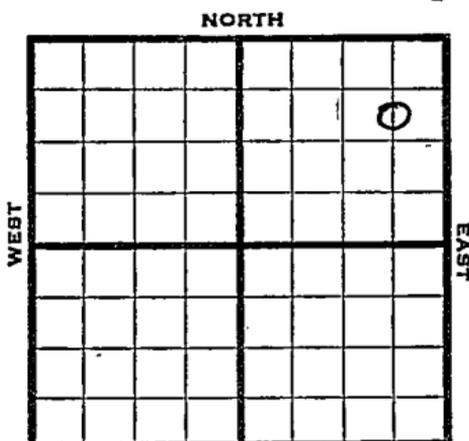

C S L NE NE *Ells. 1770* SOUTH

1944

R E P O R T

Date	Location
11/22	Location
11/29	"
12/6	"
12/14	8" @ 422' Drlg. 2705'
12/21	Anhy 520 Lans 2895 Cong 3222 Arb 3231 TD 3235 5" @ 3233
12/29	RUST " " " "
1945	
1/3	" "
1/10	TD 3239 385 oil in 7 hrs
1/17	1500 acid swb 3 oil PH
1/26	" " " " "
1/31	" " " " "
2/7	" " " " "
2/14	" " " " "
2/21	Arb. 3231 5" @ 3233 TD 3239 Pump 75 Pot. Grav. 42.3

COMPLETED

Pool Name Stoltenberg

Map No. 55 Sec. 13 Twp. 17 R. 10W

Well No. 2 Wilkens

Bay Pet. Company

FIRST REPORT Contractor

O S L N E N E

SECTION PLAT

990 Ft. from N. Line

_____ Ft. from S. Line

660 Ft. from E. Line

_____ Ft. from W. Line

			o

Ellsworth

Location X

Rig up _____

Drilling and Remarks:

RECORD

Cased _____ in., _____ ft.

Sand _____

Gas _____

Oil _____

Total Depth _____

PRODUCTION

1st 24 hrs. Nat. _____

1st 24 hrs. after shot _____

Gas _____ Cu. Ft.

Dry Hole _____

Abandoned _____

Date

NOV 22 1944

19

S. J. LEWIS

Scout

Misc C. all items *Hand*

Cards *DA*

Traci *ML*

Franco *Hand*

Scarb *Hand*

Pierce *ML*

Geof

Pierce

Pool Name Stoltenberg

Map No. 55 Sec. 13 Twp. 17 R. 10 W.

Well No. 2 Wilkens

Bay Pet. Company

COMPLETED Contractor

C S L N E N E

SECTION FLAT

990 Ft. from N. Line

_____ Ft. from S. Line

660 Ft. from E. Line

_____ Ft. from W. Line

Ellsworth

RECORD

Location _____

Cased _____ in., _____ ft.

Rig up _____

Sand _____

Drilling and Remarks:

Gas _____

Cor 3231

Oil _____

5" @ 3233

Total Depth 3239

Pump 75 P.D.

PRODUCTION

1st 24 hrs. Nat. _____

1st 24 hrs. after shot _____

Gas _____ Cu. Ft.

Dry Hole _____

Abandoned _____

42 3/4

Date

FEB 2 1 1945

19

S. J. LEWIS Scout

Misc. Small Maps	<u>LR</u>
Cards	<u>LR</u>
Tracing	<u>LR</u>
France Map	<u>LR</u>
Scarborough Map	<u>LR</u>
Pierce Map	<u>LR</u>
Geological Dept.	_____
Pierce & Cook	_____