KANSAS

FORM 51 5M 1-42 PETROL


Ellsworth

Section 13 Township 17 Range 10-W

Well No. #1 Wilkins "C"

Company C.E.Ash

Stoltenberg Pool

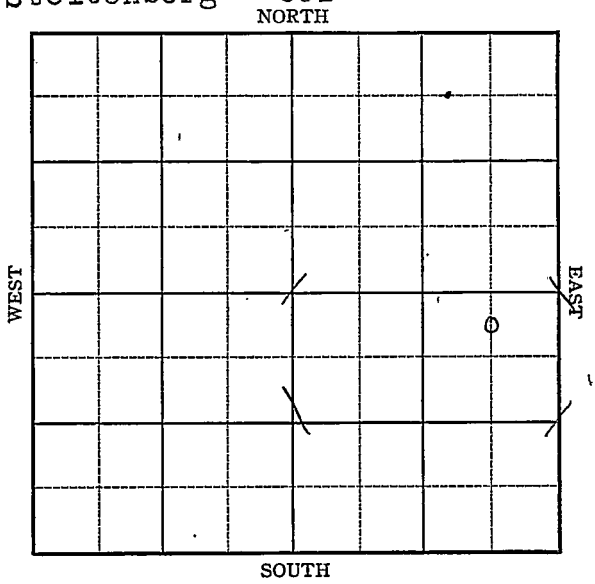

Form 252-A
5M 5-42 Petrol

KANSAS

Ellsworth

Sec. 13 Twp. 17 R. 10-W

Well No. #1 Wilkins "C" Farm

C E ASh Company


Stoltenberg pool

330 Ft. from N. Line

Ft. from S. Line

660 Ft. from E. Line

Ft. from W. Line

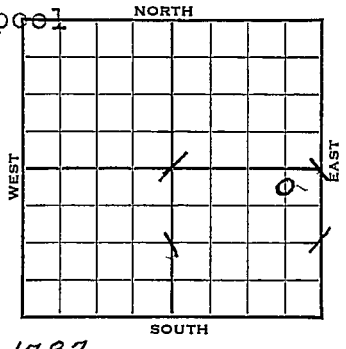

C NL NE SE Elev. 1787

1942	REPORT
11/24	Loc.
12/2	8" @ 216 Anhy 510 Drlg. 2421
12/9	Lams 2980 arp 3255 TD 3279 5" @ 3260 rust
12/16	SD
12/22	"
12/29	"
1943 1/6	"
1/13	TD 3277' SSO
1/20	20 qts pipe collapsed.
1/27	Swab edge pipe.
2/3	" "
2/10	CO
2/17	200' oil in 12 hrs 1000 acid.
2/24	Arb. 3252 5" @ 3260' T.D. 3279' Water ABANDONED

Form 26 200 Bks 5-42 Petrol Ellsworth

KANSAS

Map No. 29 Sec. 13 Twp. 17 R. 10W

Well No. 1 Wilkins "C"

C. E. Ash Company

FIRST REPORT Contractor

C NL NE SE


330 Ft. from N. Line

Ft. from S. Line

660 Ft. from E. Line

Ft. from W. Line

SECTION PLAT

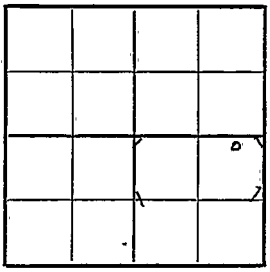

STOLTENBERG POOL

Location XXX

Rig up

Drilling and Remarks:

RECORD

Cased in., ft.

Sand

Gas

Oil

Total Depth

PRODUCTION

1st 24 hrs. Nat.

1st 24 hrs. after shot


Gas Cu. Ft.

Dry Hole

Abandoned

Date

NOV 24 1942 19 S. I. LEWIS Scout

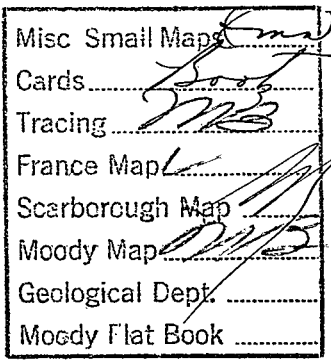
Misc Small Maps
Cards
Tracing
France Map
Scarborough Map
Moody Map
Geological Dept.
Moody Flat Book

Form 26 200 Bks 5-42 Petrol

KANSAS — Ellsworth

Map No. 53 Sec. 13 Twp. 17 R. 10W

Well No. 1 Wilkins "C"

C. E. Ash Company

ABANDONED Contractor

C NL NE SE


330 Ft. from N. Line

____ Ft. from S. Line

660 Ft. from E. Line

____ Ft. from W. Line

SECTION PLAT

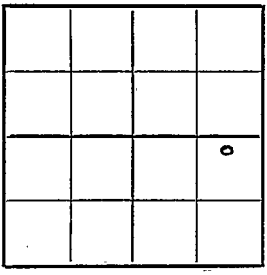

STOLTENBERG POOL

Location

Rig up

Drilling and Remarks:

Cir & 3252
5" @ 3260
Water

RECORD

Cased ____ in., ____ ft.

Sand

Gas

Oil

Total Depth 3279

PRODUCTION

1st 24 hrs. Nat.

1st 24 hrs. after shot


Gas ____ Cu. Ft.

Dry Hole

Abandoned

Date

FEB 24 1943 19 S. J. LEWIS Scout

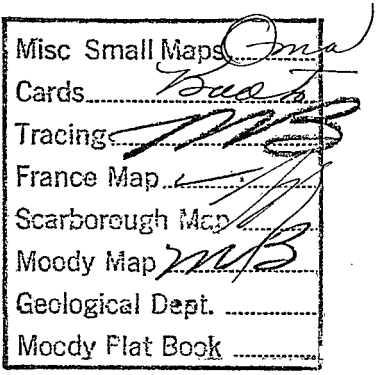
Misc Small Maps
Cards
Tracing
France Map
Scarborough Map
Moody Map
Geological Dept.
Moody Flat Book