

KANSAS


FORM 51 5M 4-41 PETROL Ellsworth

Section 13 Township 17 Range 10-W

Well No. #1 Wilkins "D"

Company C.F. Ash et al

NORTH Stoltenberg Pool

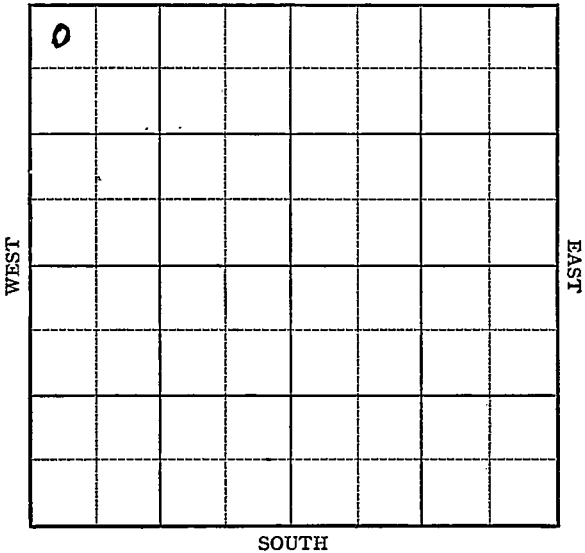

Sec. 13 Twp. 17 R. 10-W

 Well No. #1 Wilkins "B" Farm


C. E. Ash et al Company
(Stoltenberg)
330 Ft. from N. Line

_____ Ft. from S. Line

_____ Ft. from E. Line

330
~~440~~ Ft. from W. Line

Elev. 1801

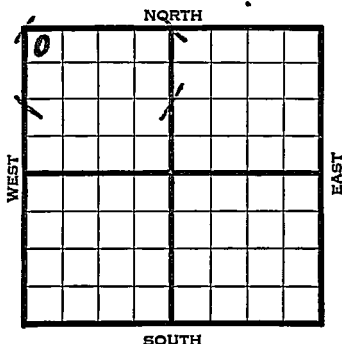
1941
REPORT

5/14 Cellar.

5/22 Rotary.

5/28 8" - 186' Anhy 525'

Drlg. 1760'

6/5 Lans. 2931' Drlg. 3186'

6/12 Arb. 3251' 5" - 3252'

T.D. 3262' RUST.

6/19 T.D. 3272' 2000' oil 2 hours.

6/26 " " " "

7/1 Arb. 3251'

5" - 3252'

T.D. 3272'

2000 acid.

Potential 1160 bbls., pump.

44. Gravity

COMPLETED

Map No. 55 Sec. 13 Twp. 17 R. 10WWell No. 1 Wilkins "D"C. E. Ash etal Companycorrection Contractor

NW/C

330 Ft. from N. Line

_____ Ft. from S. Line

_____ Ft. from E. Line

330 Ft. from W. Line

STOLTENBERG POOL

SECTION PLAT

0			

Location _____

Rig up _____

Drilling and Remarks:

Reported as

#1 Wilkins "B"

RECORD

Cased _____ in., _____ ft.

Sand _____

Gas _____

Oil _____

Total Depth _____

PRODUCTION

1st 24 hrs. Nat. _____

1st 24 hrs. after shot _____

Gas _____ Cu. Ft.

Dry Hole _____

Abandoned _____

Date

MAY 22 1941S. J. LEWIS Scout

Misc. Small Maps
Cards
Tracings
France Map
Scarborough Map
Moody Map
Geological Dept.
Moody Flat Book

Map No. 55 Sec. 13 Twp. 17 R. 10W

Well No. 1 Wilkins "B"

C. E. Ash etal Company

FIRST REPORT Contractor

NW/C

330 Ft. from N. Line

_____ Ft. from S. Line

_____ Ft. from E. Line

440 Ft. from W. Line

STOLTENBERG POOL

SECTION PLAT

Location _____

Rig up _____

Drilling and Remarks:

Cellar

RECORD

Cased _____ in., _____ ft.

Sand _____

Gas _____

Oil _____

Total Depth _____

PRODUCTION

1st 24 hrs. Nat. _____

1st 24 hrs. after shot _____

Gas _____ Cu. Ft.

Dry Hole _____

Abandoned _____

Date

MAY 14 1941 19 _____ S. J. LEWIS Scout

Misc. Small Maps

Cards

Tracing

France Map

Scarborough Map

Moody Map

Geological Dept.

Moody Flat Book

Map No. _____ Sec. 13 Twp. 17 R. 10W

Well No. 1 Wilkins #D

C. E. Ash etal Company

COMPLETED Contractor

SECTION PLAT

NW/C

330 Ft. from N. Line

_____ Ft. from S. Line

_____ Ft. from E. Line

440 Ft. from W. Line

o			

STOLTENBERG POOL

RECORD

Location _____

Cased _____ in., _____ ft.

Rig up _____

Sand _____

Drilling and Remarks:

Gas _____

Oil _____

Total Depth 3272

*Ar 83207
5" @ 3252
2000 cu ft
Pump 1160 P.D.*

PRODUCTION

1st 24 hrs. Nat. _____

1st 24 hrs. after shot _____

Gas _____ Cu. Ft.

Dry Hole _____

Abandoned _____

44^o SW

Date

JUL 1 1941 19 S. I. LEWIS Scout

Misc. Small Maps
Cards
Tracing
France Map
Scarborough Map
Moody Map
Geological Dept.
Moody Plat Book