

Map No. KANSAS Sec. 13 Twp. 17 R. 9W


Well No. 2-Nienke Farm
Bradley & Scaulon Company

330 Ft. from N. Line

_____ Ft. from S. Line

_____ Ft. from E. Line

330 Ft. from W. Line

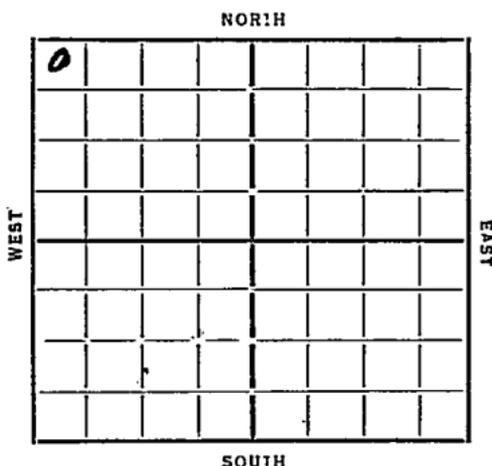

Date 7/3/5 REPORT O.W.B.B

3/27 Location

4/4 Rgn

4/11 dly 185

4/18 2

4/26 dly 355 15" 306

5/2 " 1250 17" 420

5/9 " 1810 10" 1793

5/16 8" 2180 2 7/8 Gal 2180-95

Lowering 8"

5/23 dly 2885 8" 2210

5/29 pausing 2850 50 2933

50 3037-45 Rimp 3167

T 7 3175 6" 2965

6/6 Sil 3207-09 T 7 H.P.O.

6/12 Sil 3207 T 7 3209

1190 Bbls.

COMPLETED

1936 O.W.B.B

10/28 Old total depth 3209'

Plugged back to 3060'

3700 gallons of acid, Pot. 151 bbls.

FIRST REPORTS - AND - COMPLETED

Map No. 45 Sec. 13 Twp. 17 R. 9W

Well No. 2 Niemke

Bradley & Scarborough Company

Contractor

SECTION PLAT

0			

380 Ft. from N. Line

_____ Ft. from S. Line

_____ Ft. from E. Line

330 Ft. from W. Line

COMPLETED
FIRST REPORT

OW-BB

Location O. W. B B

RECORD

Cased _____ in., _____ ft.

Sand _____

Gas _____

Oil _____

Total Depth _____

PRODUCTION

1st 24 hrs. Nat. _____

1st 24 hrs. after shot _____

Gas _____ Cu. Ft.

Dry Hole _____

Abandoned _____

Rig up _____

Drilling and Remarks:

Old #11 3209

PB 3060

3700 acid

P 8 151

Date

OCT 23 1935

S. J. LEWIS

Scout

[Handwritten scribbles and lines]

[Handwritten signature]

Returned	<i>[Signature]</i>
Cards	<i>[Signature]</i>
Tracing	<i>[Signature]</i>
France Map	<i>[Signature]</i>
Scarborough Map	<i>[Signature]</i>
Moody Map	<i>[Signature]</i>
Scarborough Plat Book	<i>[Signature]</i>
Moody Plat Book	<i>[Signature]</i>

Map No. 45 Sec. 13 Twp. 17 R. 9W

Well No. 2-Menke

Bradley + Scanlon Company

Contractor

FIRST REPORT

SECTION PLAT

330 Ft. from N. Line

..... Ft. from S. Line

..... Ft. from E. Line

330 Ft. from W. Line

0			

Location

Rig up

Drilling and Remarks:

RECORD

Cased.....in.,ft.

Sand.....

Gas.....

Oil.....

Total Depth.....

PRODUCTION

1st 24 hrs. Nat.....

1st 24 hrs. after shot.....

Gas..... Cu. Ft.

Dry Hole.....

Abandoned.....

Date

ORVAL MANNSCHRECK

3-27-32 192..... Scout

Handwritten scribbles and lines, possibly a signature or initials, extending diagonally across the page.

Returned	<i>MA</i>
Cards	<i>MA</i>
Tracing	<i>MA</i>
France Map	<i>x</i>

Map No. 45 Sec. 13 Twp. 17 R. 9W

Well No. 2-Nienke

Bradley + Seaton Company

Contractor

~~COMPLETED~~

SECTION PLAT

330 Ft. from N. Line

Ft. from S. Line

Ft. from E. Line

330 Ft. from W. Line

0			

Location

Rig up

Drilling and Remarks:

1190 ftho

RECORD

Cased in. ft.

Sand Oil 3207

Gas

Oil

Total Depth 3209

PRODUCTION

1st 24 hrs. Nat.

1st 24 hrs. after shot

Gas Cu. Ft.

Dry Hole

Abandoned

Date

ORVAL MANNSCHECK

6-12-35 192

Scout

no work
P.S.

Books	CD
Series	CD
France	X
Section of	X
...	X
See thorough File Book	
Moody File Book	