

EAST LORRAINE PROSPECT

State Kansas County Ellsworth


Company Messman-Rinehart Oil Co. Well No. 1

Farm Desbrow (washdown)

Survey _____

Block No. _____ Sec. 13 Twp. 17 S Range 9 W

Co-Ord. _____ Elev. 1799' R/B

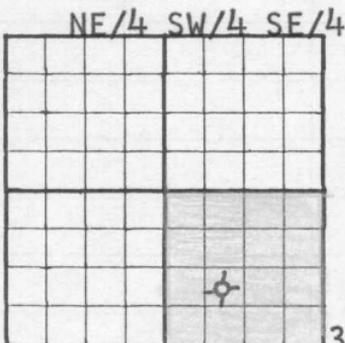

M-R Rig
 34% - A. A. Seeligson, Jr.
 16% - Ramona F. Seeligson
 25% - L. J. Plym
 25% - Messman-Rinehart Oil

8" @ 210 - washdown of
 K&E #1 Sauberli
 3241 Arb. test to be comm.
 by 12/10/65

NOTE: Show Sketch of Lease and Well Location in Above Space

Ft. from N. Line

Ft. from S. Line

Ft. from W. Line

Ft. from E. Line

Date	Depth	
12/7/65		M.I.R.T.
12/8	2130	W.D. depth
12/9	3242	C.O. to bottom (logged in hole)
	DST #1 - 3194-17	- Op 1 hr., wk bl for 15"
	(straddle)	Rec. 25' mud, BHP 86-79#,
	Simpson	FP 27-27#, BHT 94°
	DST #2 - 2875-2900'	- Op 1'30", good bl
	(straddle)	diminishing, Rec. 45' mud
	Lansing	BHP (30") 856-193, FP 21-28#
		Temp. 97°