


Section 14 Township 17 Range 9W

Well No. 1 Dees

Company Dozier Oil

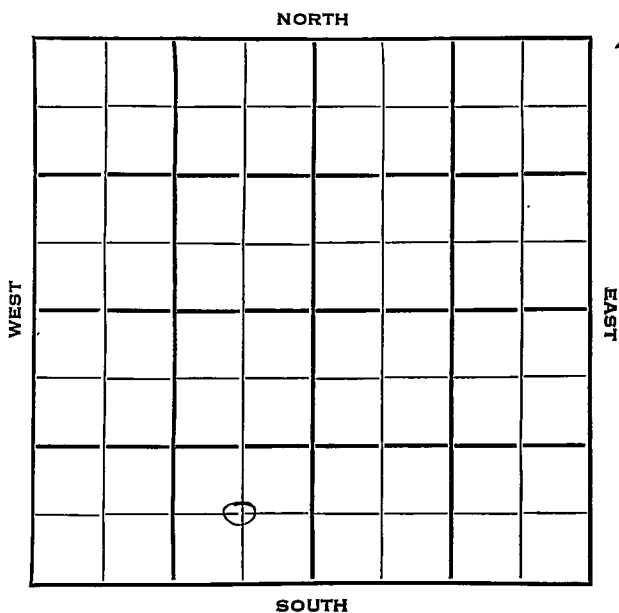

Ellsworth KANSAS

SEC. 14 TWP. 17 R. 9W ✓

WELL NO.

1 Dees FARM

COMPANY

Dozier Oil

CONTRACTOR

Stag Drlg.

_____ Ft. from N. Line


660

_____ Ft. from S. Line

660

_____ Ft. from E. Line

_____ Ft. from W. Line

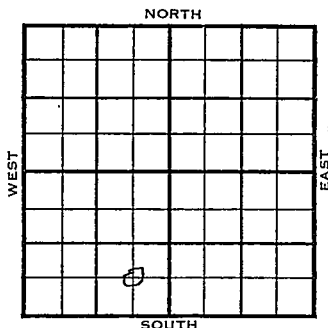

C SE SW

1954

ELEVATION
1771'

REPORT

1/13

Spud 1-2-54

D&A

TD 3177'

8" @ 235'

Heeb 2712', Br lime 2829', Lans 2848'

Arb. 3175'

TD 3177'

D&A

FIRST REPORT



ABANDONED

County **Ellsworth** State **Kansas**

Sec. **14** (Blk. Twp.) **17** (Sur. Rge.) **9W** Map No.

Operator **Dozier Oil**

Well No. **1** Farm **Dees**

Elev. **1771** Location **C SE SW**



660 Ft. From **S** Line **SW**

660 Ft. From **E** Line Quarter

1st. Report **JAN 13 1954**

Completion **JAN 13 1954**

Remarks

Stag Drlg. - Contr.

Spudding Date **1-2-54**

Drlg. Data **D & A TD 3177**

8" @ 235 Heeb. 2712 Br. lime 2829

Lans. 2848 Arb. 3175 TD 3177

D & A