


Ellsworth

Map No. KANSAS Sec. 14 Twp. 17 R. 9W

Well No. 2-Deer Farm
Skelly oil Company

990 Ft. from N. Line
Ft. from S. Line
330 Ft. from E. Line
Ft. from W. Line

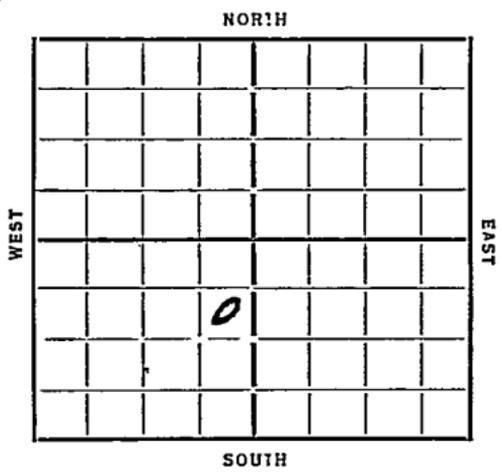

Date 1955 REPORT

7/24 Call
8/8 12" 217 WOC
8/15 dly 2268
8/22 " 3110
8/29 Sib 3171 7" 3171
3174 T₁ Rust
9/6 T₁ 3170 H.F.O.
10/2 Sib 3171
T₁ 3174
2203 Blk.

COMPLETED

Map No. 45 Sec. 14 Twp. 17 R. 9 W.

Well No. 2 Tree

Skelly Oil Company

Contractor

FIRST REPORTS

990 Ft. from N. Line

..... Ft. from S. Line

230 Ft. from E. Line

..... Ft. from W. Line

SECTION PLAT

Location.....

Rig up.....

Drilling and Remarks:

Cellar

RECORD

Cased.....in.,ft.

Sand.....

Gas.....

Oil.....

Total Depth.....

PRODUCTION

1st 24 hrs. Nat.....

1st 24 hrs. after shot.....

Gas.....Cu. Ft.

Dry Hole.....

Abandoned.....

Date

7/27/35 192

URVAL MANNSCHECK

Scout

Map No. 45 Sec. 14 Twp. 17 R. 9W

Well No. 2-Dees

Spelly Oil Company

Contractor

COMPLETION

SECTION PLAT

990 Ft. from N. Line.

..... Ft. from S. Line

330 Ft. from E. Line

..... Ft. from W. Line

Location.....

Rig up.....

Drilling and Remarks:

RECORD

Cased..... in., ft.

Sand Sil 3171

Gas.....

Oil.....

Total Depth 3174

PRODUCTION

1st 24 hrs. Nat.....

1st 24 hrs. after shot.....

Gas..... Cu. Ft.

Dry Hole.....

Abandoned.....

2203 Hb

Date

10-2-35 192 **ORVAL MANNSCHECK** Scout