

*Ellsworth*  
17 9W

Map No. **KANSAS** Sec. *14* Twp. *17* R. *9W*


Well No. *4 - deep* Farm \_\_\_\_\_  
*Shelly oil* Company \_\_\_\_\_

NORTH

*14*

WEST

EAST

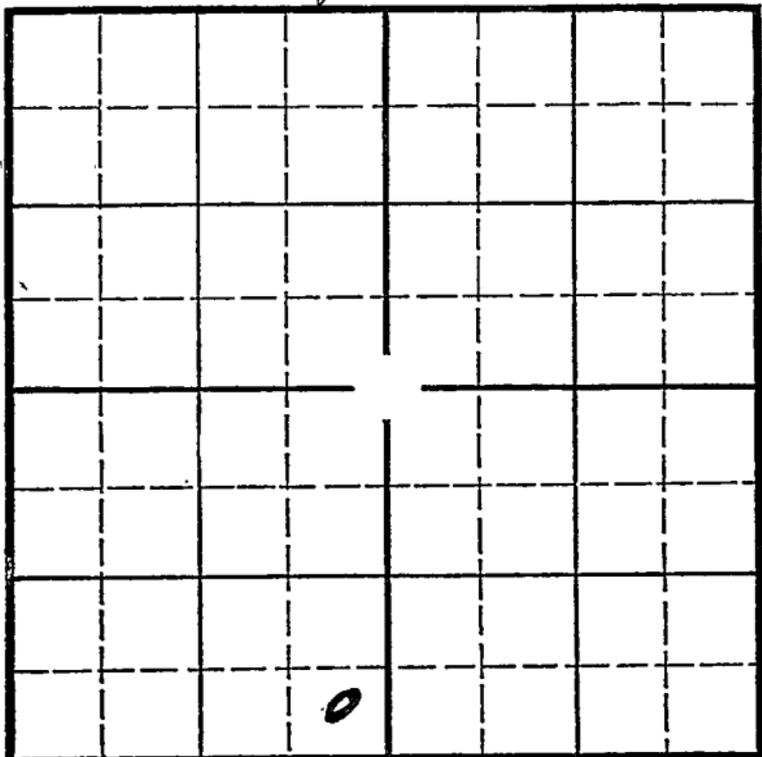

SOUTH

Location \_\_\_\_\_  
Drilling Remarks \_\_\_\_\_

Rig Up \_\_\_\_\_  
Drilling Remarks \_\_\_\_\_

\_\_\_\_\_  
\_\_\_\_\_  
**RECORD**

**PRODUCTION**

Cased \_\_\_\_\_ in. \_\_\_\_\_ ft.  
Sand \_\_\_\_\_  
Gas \_\_\_\_\_  
Oil \_\_\_\_\_  
Total Depth \_\_\_\_\_

1st 24 hrs. Nat. \_\_\_\_\_  
1st 24 hrs. after shot \_\_\_\_\_  
Gas \_\_\_\_\_ cu. ft. \_\_\_\_\_  
Dry Hole \_\_\_\_\_  
Abandoned \_\_\_\_\_

Ellsworth  
17 9<sup>th</sup>

Map No. KANSAS Sec. 14 Twp. 17 R. 9<sup>th</sup>

Well No. 4-Deer Farm  
Skelly Oil Company


\_\_\_\_\_ Ft. from N. Line

330 Ft. from S. Line

330 Ft. from E. Line

\_\_\_\_\_ Ft. from W. Line

Elev. 1769

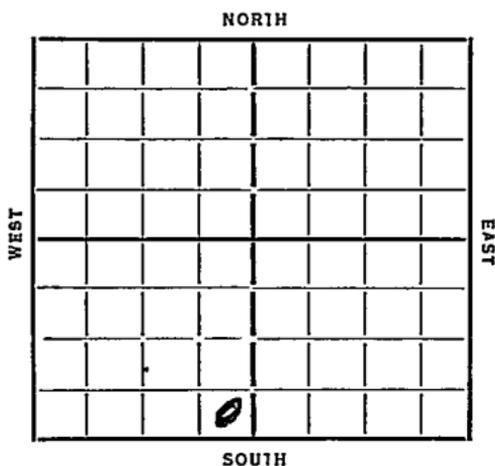

Date	REPORT
1935	
8/14	Location
8/27	Cellar
8/29	Run
9/6	Dip 1375
10/2	Dip 3167
	711 3171
	1000 acid
	2308 Hbls.
	COMPLETED

12" 204

Map No. 45 Sec. 14 Twp. 17 R. 9W

Well No. 4-Dees

Spelly oil

Company

Contractor

**FIRST REPORT**

SECTION PLAT


Ft. from N. Line

330

Ft. from S. Line

330

Ft. from E. Line

Ft. from W. Line

**FIRST REPORT**

Location ✓

Rig up

Drilling and Remarks:

RECORD

Cased.....in., .....ft.

Sand.....

Gas.....

Oil.....

Total Depth.....

PRODUCTION

1st 24 hrs. Nat.....

1st 24 hrs. after shot.....

Gas.....Cu. Ft.

Dry Hole.....

Abandoned.....

Date

ORVAL MANNSCHRECK

8-14-35 192

Scout


Map No. 45 Sec. 14 Twp. 17 R. 9W

Well No. 4-Blue

Spelly oil Company

Contractor

SECTION PLAT

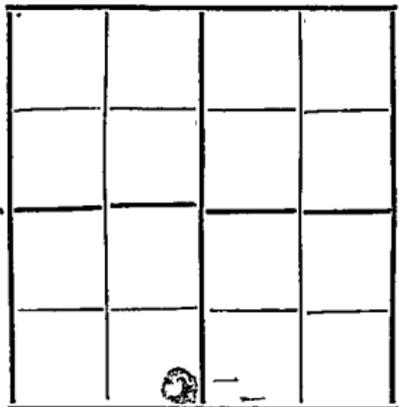

..... Ft. from N. Line

330 Ft. from S. Line

330 Ft. from E. Line

..... Ft. from W. Line

Location.....

Rig up.....

Drilling and Remarks:

1000 and

2308 fms

RECORD

Cased..... in. .... ft.

Sand oil 3167

Gas.....

Oil.....

Total Depth 3171

PRODUCTION

1st 24 hrs. Nat.....

1st 24 hrs. after shot.....

Gas..... Cu. Ft.

Dry Hole.....

Abandoned.....

Date

10-2-35

192 ORVAL MANNSCHECK Scout