

Map No. KANSAS Sec. 14 Twp. 17 R. 9W
 Well No. 8-Deer Farm _____
Shelly Oil Company _____

NORTH

WEST

EAST

SOUTH

Location _____
 Drilling Remarks _____

Rig Up _____
 Drilling Remarks _____

RECORD

Cased _____ in. _____ ft.
 Sand _____
 Gas _____
 Oil _____
 Total Depth _____

PRODUCTION

1st 24 hrs. Nat. _____
 1st 24 hrs. after shot _____
 Gas _____ cu. ft. _____
 Dry Hole _____
 Abandoned _____

Ellsworth

Form 252-A
5M 7-34 MPC

Map No. **KANSAS**

Sec. **14** Twp. **17** R. **9W**

Well No. **8-Deer** Farm
Shelly Oil Company


Ft. from N. Line

330 Ft. from S. Line

Ft. from E. Line

990 Ft. from W. Line

Eleg. 1778

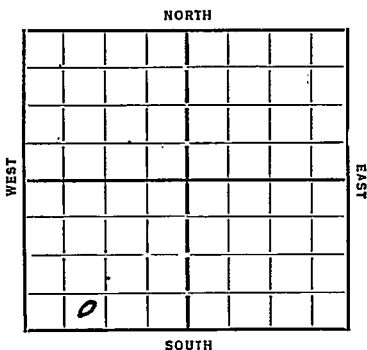

Date

REPORT

10/1/7 Rig up
11/1/7 ~~2360~~ **3187**
11/7 **7" 3187 Sil 3189-92 Root**
11/14 —
11/20 **Sil 3187 Corrected**
TD 3190
2267 Holes 7% W.

COMPLETED

Edwards

KANSAS

Map No. 45 Sec. 14 Twp. 17 R. 9W

Well No. 8-Dee

Spelly Oil Company

Contractor

SECTION PLAT

0			

Ft. from N. Line

330 Ft. from S. Line

Ft. from E. Line

990 Ft. from W. Line

FIRST REPORT

Location

Rig up ✓

Drilling and Remarks:

RECORD

Cased in., ft.

Sand

Gas

Oil

Total Depth

PRODUCTION

1st 24 hrs. Nat.

1st 24 hrs. after shot

Gas Cu. Ft.

Dry Hole

Abandoned

Date

ORVAL MANNSCHRECK

10-17-35 192 Scout

Edwards
 Map No. *45* Sec. *14* Twp. *17* R. *9W*
 Well No. *8-Dees*
Skelly oil Company
 Contractor

COMPLETE


Ft. from N. Line

330 Ft. from S. Line

Ft. from E. Line

990 Ft. from W. Line

SECTION PLAT

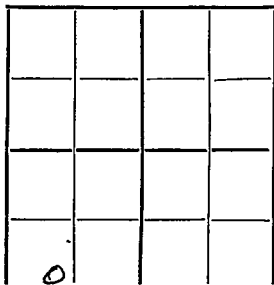

Location

Rig up

Drilling and Remarks:

RECORD

Cased in.

Sand *Sil. 3187* *contacted*

Gas

Oil

Total Depth *3190*

PRODUCTION

1st 24 hrs. Nat.

1st 24 hrs. after shot

Gas Cu. Ft.

Dry Hole

Abandoned

226.7 lbs
20% W

Date

11-20-35 192 *ORVSE* *LANSCHEIM* Scout