

Ellsworth


Form 51-5M-5-34-Palace

Map No. KANSAS Sec. 14 Twp. 17 R. 9 W

Well No. Mahoney Farm
Bradley & Scanton Company

NORTH

16

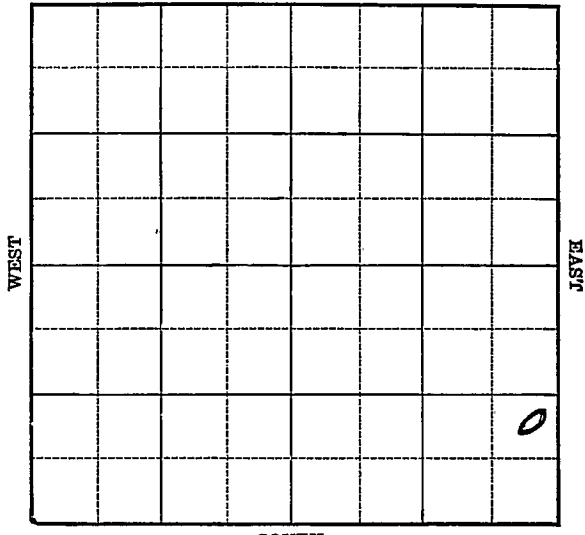

SOUTH

Location _____

Drilling Remarks _____

RECORD

Cased _____ in. _____ ft.

Sand _____

Gas _____

Oil _____

Total Depth _____

Rig Up _____

Drilling Remarks _____

PRODUCTION

1st 24 hrs. Nat. _____

1st 24 hrs. after shot _____

Gas _____ cu. ft.


Dry Hole _____

Abandoned _____

Map No. KANSAS Sec. 14 Twp. 17 R. 9w

Well No. 1 Mahoney Farm
Bradley & Scanton Company

_____ Ft. from N. Line
990 Ft. from S. Line
330 Ft. from E. Line
_____ Ft. from W. Line

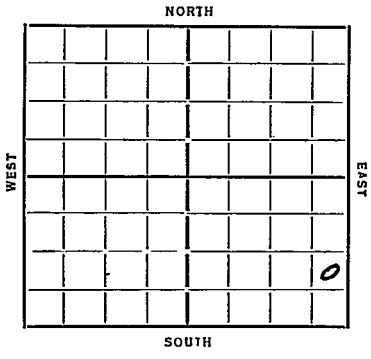

Date	REPORT
1/27	Cells
1/10	Material
1/17	Bldg
1/24	Rign
1/31	Spud
2/7	15" 320 12 1/2 513
2/14	Dly 1525
2/21	10" 1838 HFW 2210
2/28	Dly 2745 8" 2218
3/7	HFW 2970-77 6" 2980
	S.O. 3055-59 Dly 3137
3/14	Silicious 3194 Pay 3196 1/2
	T.D. 3199 HFO 30 Min.
3/20	Silicious 3194 Oil 3196
	T.D. 3199 1462 Bbls.
	COMPLETED

Form 26-1M-BK 928
E. E. Worth

KANSAS

Map No. *45* Sec. *14* Twp. *17* R. *9W*

Well No. *1-Mahoney*

Bradley & Scanton Company

Contractor

FIRST REPORTS

SECTION PLAT

..... Ft. from N. Line

990 Ft. from S. Line

330 Ft. from E. Line

..... Ft. from W. Line

			o

Location.....

Rig up.....

Drilling and Remarks:

cellar

RECORD

Cased..... in., ft.

Sand.....

Gas.....

Oil.....

Total Depth.....

PRODUCTION

1st 24 hrs. Nat.....

1st 24 hrs. after shot.....

Gas..... Cu. Ft.

Dry Hole.....

Abandoned.....

Date

1-2-35 192.....

ORVAL MANNSCHRECK

Scout

Form 28-1M BLS
Edwards

KANSAS

Map No. *45* Sec. *14* Twp. *17* R. *9W*

Well No. *1-Mahoney*

Bradley & Scanlon Company

Contractor

COMPLETED

SECTION PLAT

..... Ft. from N. Line

990 Ft. from S. Line

330 Ft. from E. Line

..... Ft. from W. Line

Location.....

Rig up.....

Drilling and Remarks:

1462 Hb

RECORD

Cased..... in., ft.

Sand *Silicious 3194*

Gas.....

Oil *3196*

Total Depth *3199*

PRODUCTION

1st 24 hrs. Nat.....

1st 24 hrs. after shot.....

Gas..... Cu. Ft.

Dry Hole.....

Abandoned.....

ORVAL MANNSCHRECK

Date

3-20-35 192.....

Scout