

Ellsworth

KANSAS

Map No. _____ Sec. 14 Twp. 17 R. 9th

Well No. 5-Deer Farm _____

Skelly Oil Company _____


_____ Ft. from N. Line

330 Ft. from S. Line

990 Ft. from E. Line

_____ Ft. from W. Line

Elev. 1776

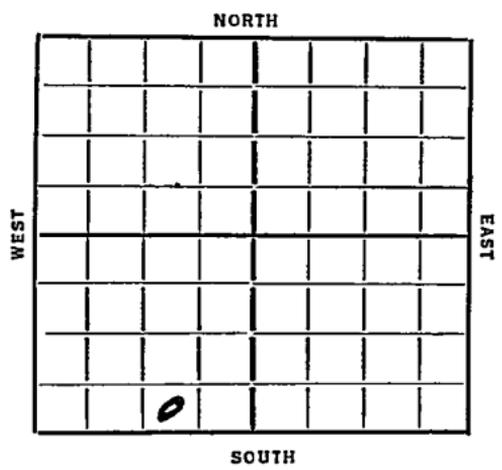

Date 1935

REPORT

9/12 Cellar

10/3 Blg 1395 12 1/2 190

10/10 Lib 3174-78 2500' 3 hrs

1000 acid

10/7 Lib 3174

TD 3178

1000 acid

2260 Blk.

COMPLETED

Form 26-1M Bls-226 *Edwards*

KANSAS

Map No. *45* Sec. *14* Twp. *17* R. *9W*


Well No. *5-Dees*
Skelly Oil Company

Contractor

FIRST REPORTS

SECTION PLAT

..... Ft. from N. Line
330 Ft. from S. Line
990 Ft. from E. Line
..... Ft. from W. Line

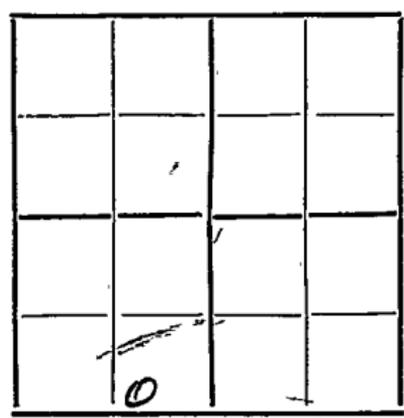

Location.....

Rig up.....

Drilling and Remarks:

cellar

RECORD

Cased..... in., ft.
Sand.....
Gas.....
Oil.....
Total Depth.....

PRODUCTION

1st 24 hrs. Nat.....
1st 24 hrs. after shot.....
Gas..... Cu. Ft.
Dry Hole.....
Abandoned.....

Date

ORVAL MANNSCHRECK

9-12-35 192

Scout

KANSAS

Map No. 45 Sec. 14 Twp. 17 R. 9W

Well No. 5-Dee

Skelly oil

Company

Contractor

COMPLETED

SECTION PLAT

.....Ft. from N. Line

330 Ft. from S. Line

990 Ft. from E. Line

.....Ft. from W. Line

Location.....

Rig up.....

Drilling and Remarks:

1000 acid

2260 bbls

RECORD

Cased.....in.,.....ft.

Sand oil 3174

Gas.....

Oil.....

Total Depth 3178

PRODUCTION

1st 24 hrs. Nat.....

1st 24 hrs. after shot.....

Gas.....Cu. Ft.

Dry Hole.....

Abandoned.....

Date

10-17-35 192.....

ORVAL MANNSCHECK

Scout