

Ellsworth

Map No. KANSAS Sec. 14 Twp. 17 R. 9W


Well No. 7- Mahoney Farm
Bradley & Scoulon Company

_____ Ft. from N. Line

990 Ft. from S. Line

990 Ft. from E. Line

_____ Ft. from W. Line

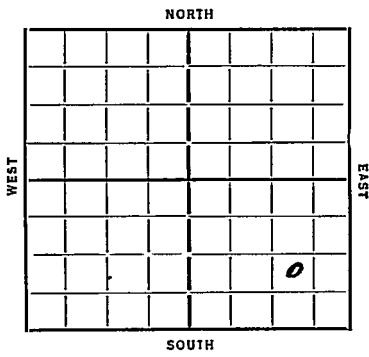

Date 1935 REPORT

3/13 Location
3/21 — 3/28 — 4/4 —
4/11 Rig
4/18 R/V
4/26 Dlg 240 15" 369
5/2 " 1175 17" 515
5/9 " 1875
5/16 " 2175 8" 1969
5/23 HFW 2200-08 8" 2228
5/29 Dlg 2240
5/29 Dlg 2935 Lansing 2895
6/6 All 3190-91 T7
Pulled in Rig
6/13 Rep Rig
6/20 T7 3194 3000' Oil
6/26 All 3191-94 T7
Pump 700 Pbls

COMPLETED

Map No. 45 Sec. 14 Twp. 17 R. 9W

Well No. 2-Mahoney

Bradley & Scanlon Company

Contractor

FIRST REPORTS

..... Ft. from N. Line

990 Ft. from S. Line

990 Ft. from E. Line

..... Ft. from W. Line

SECTION PLAT

| | | | |
|--|--|--|---|
| | | | |
| | | | |
| | | | |
| | | | 0 |

Location

Rig up.....

Drilling and Remarks:

RECORD

Cased..... in., ft.

Sand.....

Gas.....

Oil.....

Total Depth.....

PRODUCTION

1st 24 hrs. Nat.....

1st 24 hrs. after shot.....

Gas..... Cu. Ft.

Dry Hole.....

Abandoned.....

Date

3-13-35 192.....

ORVAL MANNSCHECK
Scout

Map No. *45* Sec. *14* Twp. *17* R. *9E*

Well No. *2 Shakony*

Bradley & Seaton Company
Contractor

SECTION PLAT

..... Ft. from N. Line

990 Ft. from S. Line

990 Ft. from E. Line

..... Ft. from W. Line

| | | | |
|--|--|--|--|
| | | | |
| | | | |
| | | | |
| | | | |

COMPLETED

Location.....

Rig up.....

Drilling and Remarks:

Oil 8191-94

Pump 700

RECORD

Cased..... in., ft.

Sand.....

Gas.....

Oil.....

Total Depth *3,194*

PRODUCTION

1st 24 hrs. Nat.....

1st 24 hrs. after shot.....

Gas..... Cu. Ft.

Dry Hole.....

Abandoned.....

Date

6/26/35 192.....

ORVAL MANNSCHRECK

Scout