


Ellsworth

Map No. KANSAS Sec. 14 Twp. 17 R. 9W

Well No. 3- Mahoney Farm
Bradley & Schulon Company

_____ Ft. from N. Line
330 Ft. from S. Line
990 Ft. from E. Line
_____ Ft. from W. Line

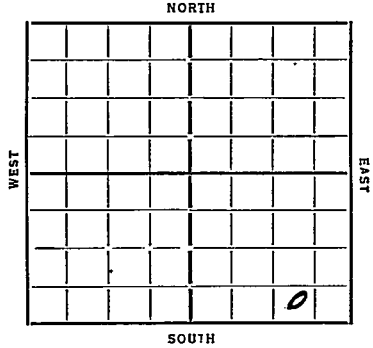

Elev. 1777

Date	REPORT
5/15	Location
5/23	Rig
5/29	6/6
6/13	Ran
6/20	Rigged
6/28	dy 750
7/3	" 1650 15" 36"
7/14	" 2100 10" 46"
7/18	" 2580
8/7	Top siliceous 3186
	T.D. 3195
	1831 bbls
	COMPLETED

Map No. 45 Sec. 14 Twp. 17 R. 9W

Well No. 3-Mahoney

Bradley & Scanlon Company

Contractor

FIRST REPORTS


SECTION PLAT

.....Ft. from N. Line

330 Ft. from S. Line

990 Ft. from E. Line

.....Ft. from W. Line

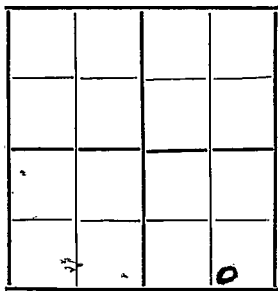

Location

Rig up:

Drilling and Remarks:

RECORD

Cased.....in.,ft.

Sand.....

Gas.....

Oil.....

Total Depth.....

PRODUCTION

1st 24 hrs. Nat.....

1st 24 hrs. after shot.....

Gas.....Cu. Ft.

Dry Hole.....

Abandoned.....

Date

5-15-35 192.....

ORVAL MANN SCHRECK

Scout

Ellsworth

Map No. 45 Sec. 14 Twp. 17 R. 9W

Well No. 3-Mahoney

Bradley & Scanlon Company

Contractor

SECTION PLAT

COMPLETED

			0

..... Ft. from N. Line

330 Ft. from S. Line

990 Ft. from E. Line

..... Ft. from W. Line

Location.....

Rig up.....

Drilling and Remarks:

1831 ft

RECORD

Cased..... in. ft.

Sand oil 3186

Gas.....

Oil.....

Total Depth 3195

PRODUCTION

1st 24 hrs. Nat.....

1st 24 hrs. after shot.....

Gas..... Cu. Ft.

Dry Hole.....

Abandoned.....

Date

8-7-35 192.....

CORV. AL. MANNSCHRECK

Scout