


Ellsworth

Map No. 14 Sec. 17 Twp. 9W

Well No. 4 - Mahoney Farm
Bradley & Sculow Company

_____ Ft. from N. Line
990 Ft. from S. Line
_____ Ft. from E. Line
990 Ft. from W. Line

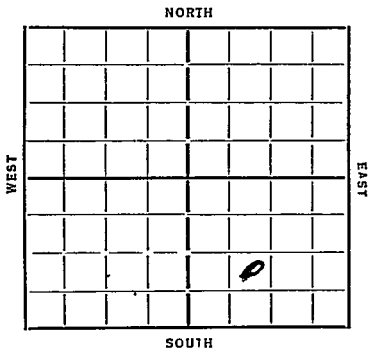

Date
7/25
6/26
7/3
7/14
7/18
8/8
8/15
8/22
8/28

REPORT

Rig up
Ran 12" 357
Log 357 10" 474
" 1780
" 3000
Log 3185 6" 3185 WOC.
Log 3185
T 7 3187
627 lbs 20 hrs.

COMPLETED

Map No. 45 Sec. 14 Twp. 17 R. 9N

Well No. H. Mahoney

Bradley & Stanton Company
Contractor

SECTION PLAT

..... Ft. from N. Line

990 Ft. from S. Line

..... Ft. from E. Line

990 Ft. from W. Line

FIRST REPORTS

Location.....

Rig up.....

Drilling and Remarks:

RECORD

Cased..... in., ft.

Sand.....

Gas.....

Oil.....

Total Depth.....

PRODUCTION

1st 24 hrs. Nat.....

1st 24 hrs. after shot.....

Gas..... Cu. Ft.

Dry Hole.....

Abandoned.....

Date

6/26/92

ORVAL MANNSCHRECK Scout

Ebbeworth

Map No. *45* Sec. *14* Twp. *17* R. *9W*

Well No. *4 - Mahoney*

Bradley & Pearson Company

Contractor

SECTION PLAT

Ft. from N. Line

990

Ft. from S. Line

Ft. from E. Line

990

Ft. from W. Line

Location.....

Rig up.....

Drilling and Remarks:

657 bbls

20 hrs

RECORD

Cased..... in., ft.

Sand: *oil 3185*

Gas.....

Oil.....

Total Depth *3187*

PRODUCTION

1st 24 hrs. Nat.....

1st 24 hrs. after shot.....

Gas..... Cu. Ft.

Dry Hole.....

Abandoned.....

Date

8-28-35 192.....

ORVAL MANNSCHECK

Scout